



JOHN DAY

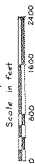


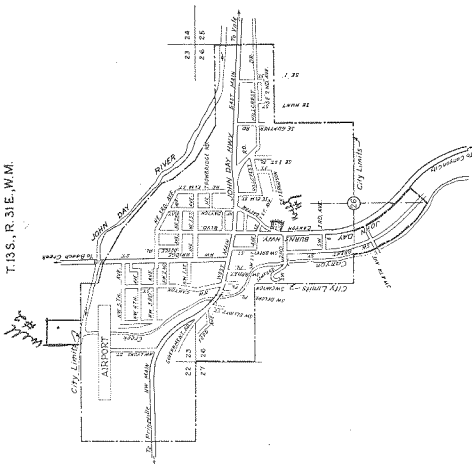

Permit G-1218
App. G-859

±

Permit G-1219
App. G-840

G-840
~~G-833~~
P61218
1219
G-1219
G-1218
30270
35080

NOT TO SCALE
11/11/48