


T. 36 S. R. 12 E. W. M.

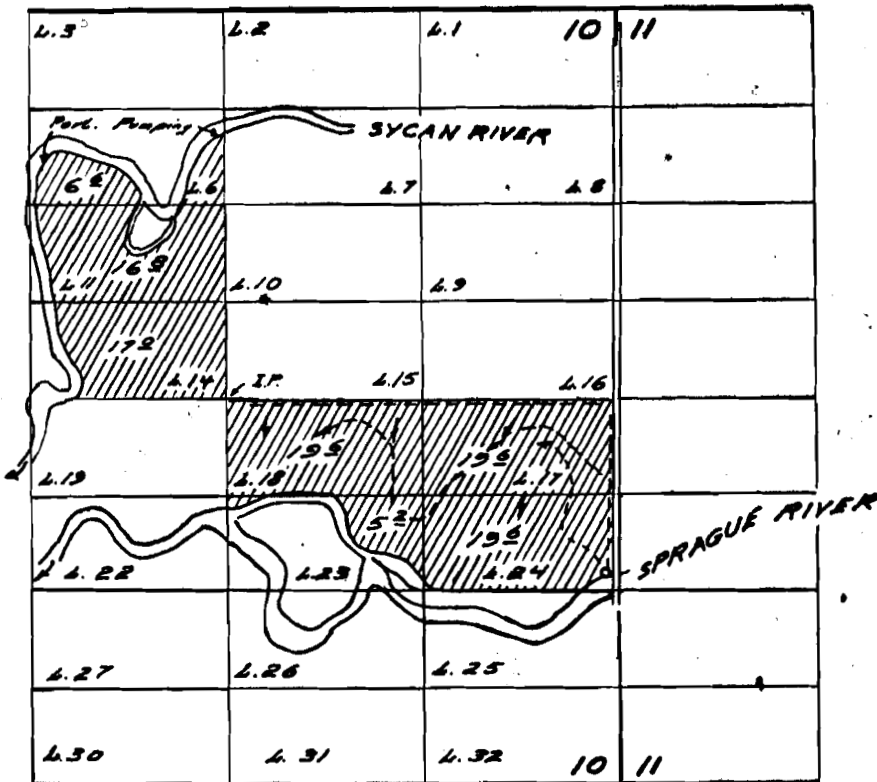

Div. 14 located 1170 Ft. S. & 2560 Ft. E.; and perhaps pumping from a point 1790 Ft. N. & 50 Ft. W. to a point 1500 Ft. N. & 1820 Ft. W. from Center Sec. 10

FINAL PROOF SURVEY UNDER

Application No. 34274 Permit No. 26972
IN NAME OF

LEWIS B. & EDITH L. MAZNEY

Surveyed Nov. 2, 1966, by N. J. RUPPAC

Sprague R.