

15 105

15 105


9 10 11 12

16 15 14 13

21 22 23 24

28 27 26 25

33 34 35 36

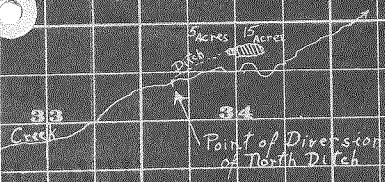

FROM OFFICE OF THE STATE ENGINEER, SALEM, OREGON

Application No.  
Permit No.