


C-46648

M-173

SP. 0- V 167 214

T-1439

T.7S. R.21E.W.M.

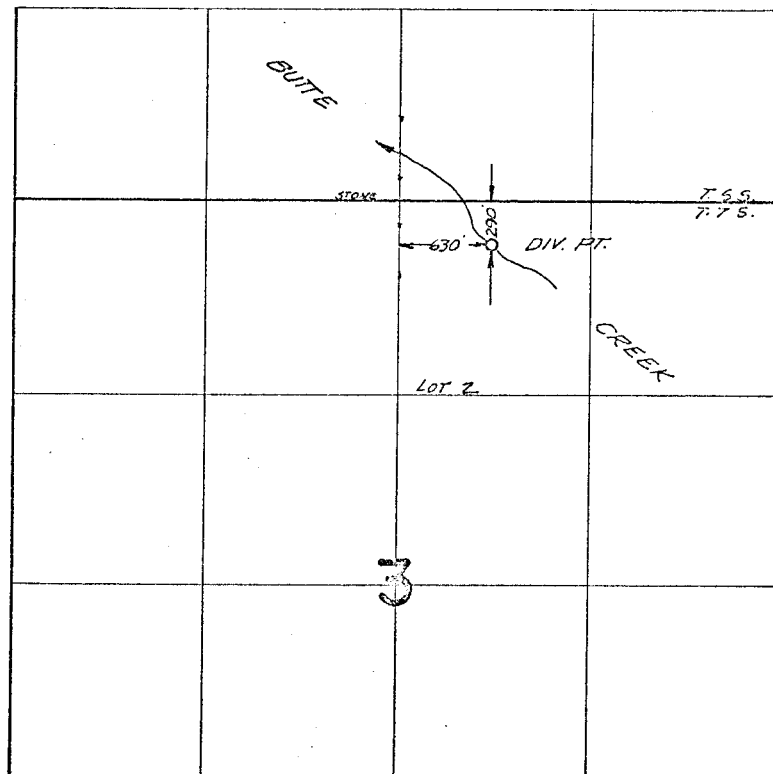

FINAL PROOF SURVEY
UNDER

TRANSFER M-173

Application No. Permit No.
IN NAME OF

..... EDGAR MYERS

Surveyed July 10, 1968, by V. Garner