


T. 8 S. R. 46 E. W.M.

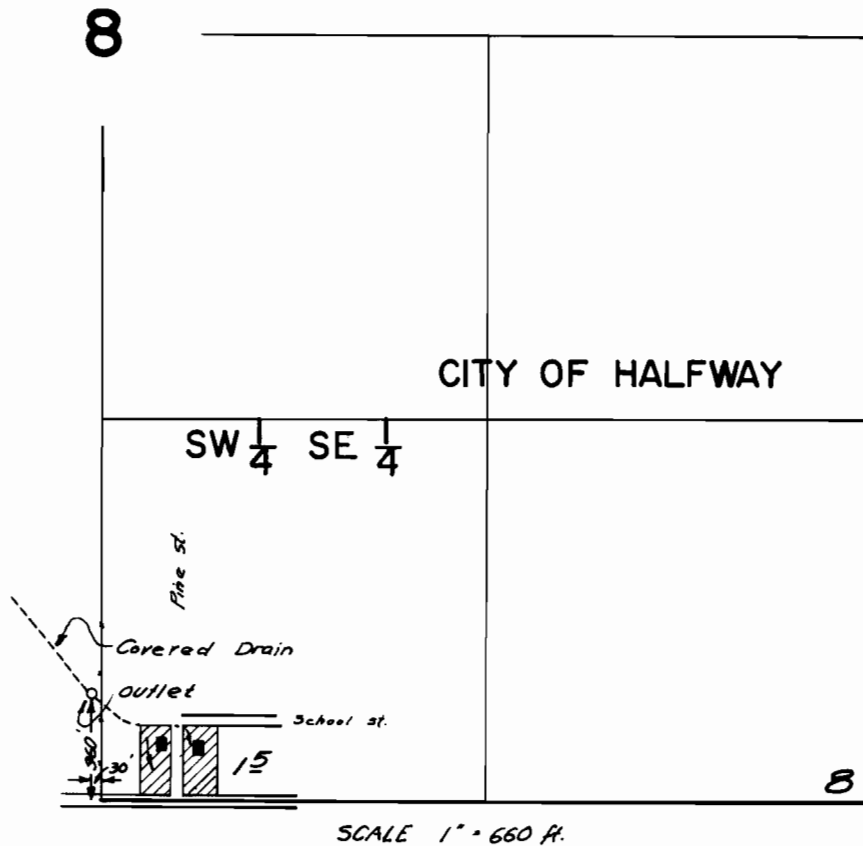

FINAL PROOF SURVEY
UNDER

Application No. G-3531 Permit No. G-3323
IN NAME OF

EVERETT PAYTON

Surveyed July 29, 1967, by V. Garner