


T.8S. R.38E.W.M.

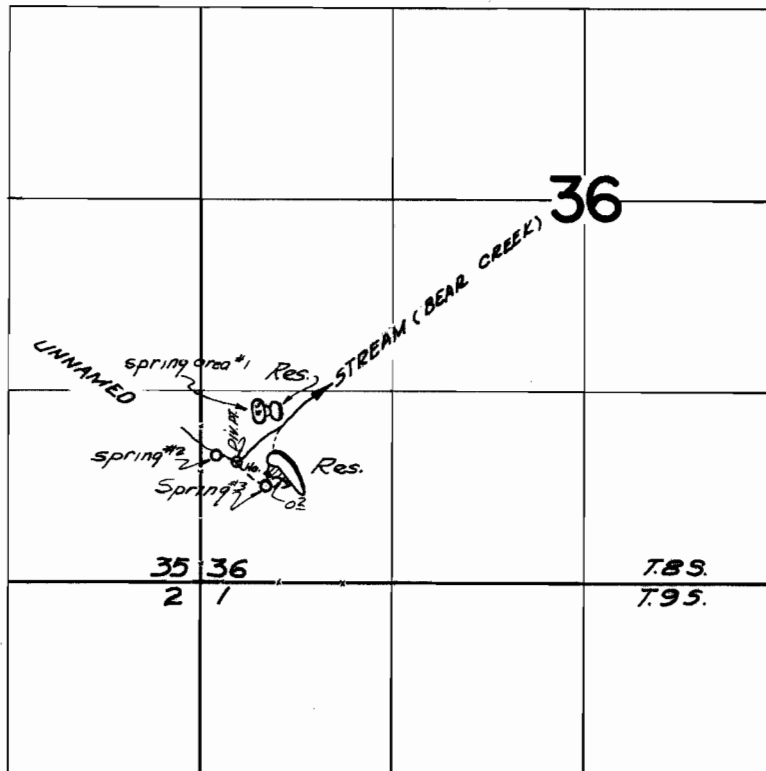

Div. pts. located:- spring area #1 1170 ft. N. & 400 ft. E.; Spring #2 870 ft. N. & 110 ft. E.; Spring #3 660 ft. N. & 440 ft. E.; unnamed stream 830 ft. N. & 250 ft. E.; all from the SW corner of section 36

FINAL PROOF SURVEY UNDER

Application No. 38180 ~~R-39489~~ Permit No. 28630 ~~R-3230~~
IN NAME OF

WILLIAM F. HEIZER

Surveyed Oct. 24, 1967, by V. Garner