


# T. 7S. R. 39E. W.M.

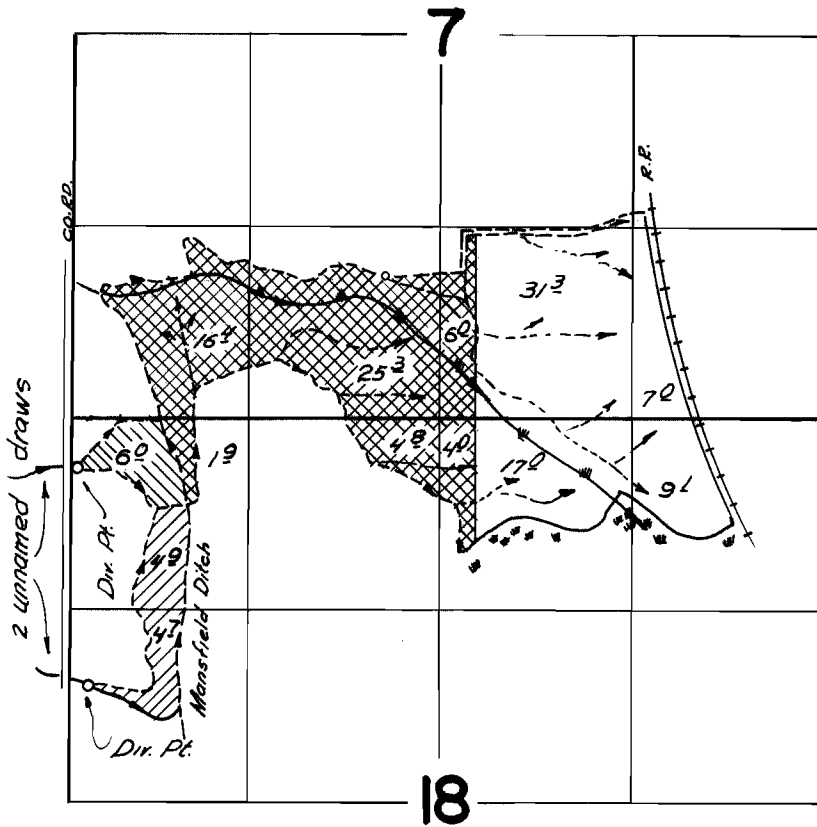

Div. Pts. located 340 ft. S. & 40 ft. E.; 1830 ft. S. & 120 ft. E.  
both from the NW cor. of Section 18

## FINAL PROOF SURVEY UNDER

Application No. 37985 Permit No. 28871  
IN NAME OF

PETER W. SCHOENINGH, JR.

Surveyed July 27, 1967, by V. Garner