


T.3S.R.IE.W.M.

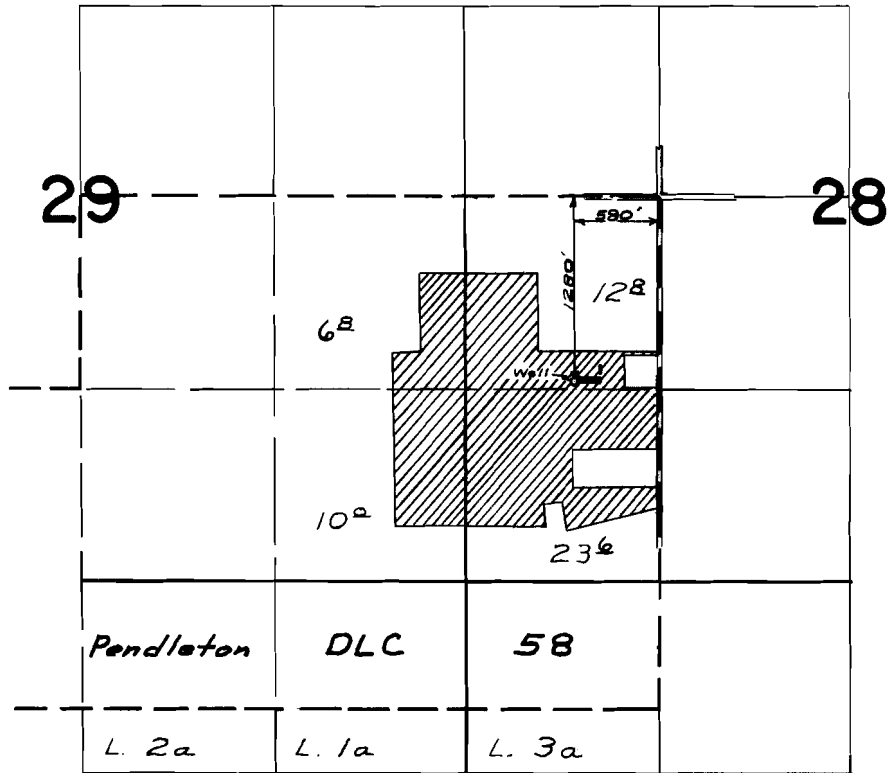

FINAL PROOF SURVEY UNDER

Application No. G-2104 Permit No. G-1935
IN NAME OF

Industrial Forestry Association

Surveyed Sept. 7, 1967, by W. J. Ruppert