


T.4S.R.3E.W.M.

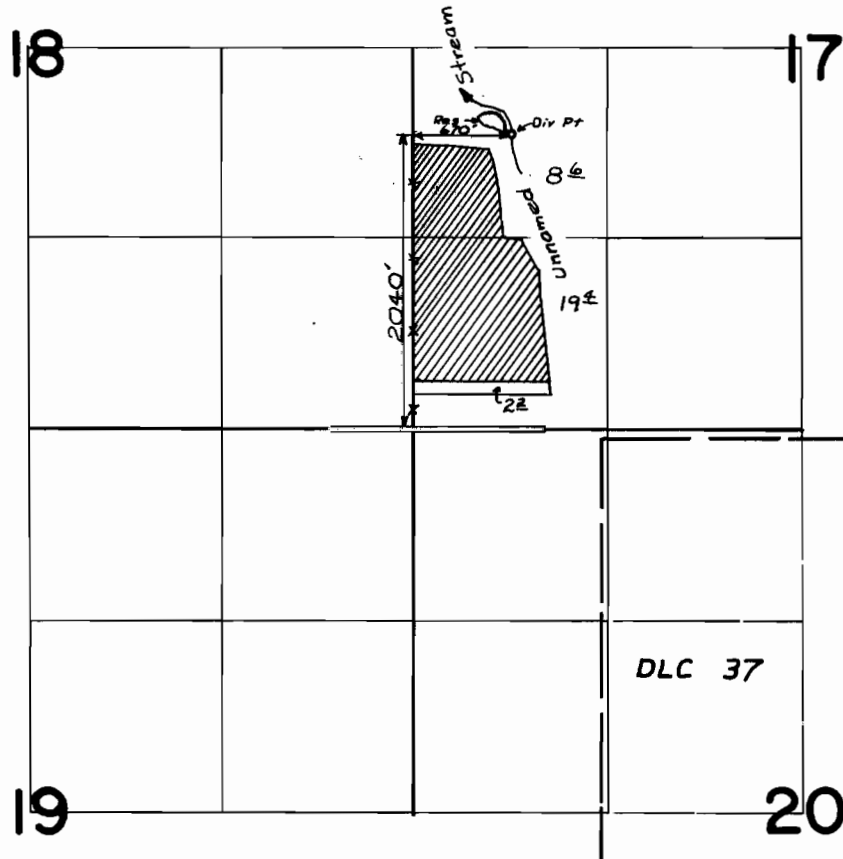

FINAL PROOF SURVEY
UNDER

Application No. R-37976 Permit No. R-3141
37977 28318
IN NAME OF

Robert Sleight

Surveyed Sept. 8, 1967, by W. W. Ruppert