


T.4S.R.3E.W.M.

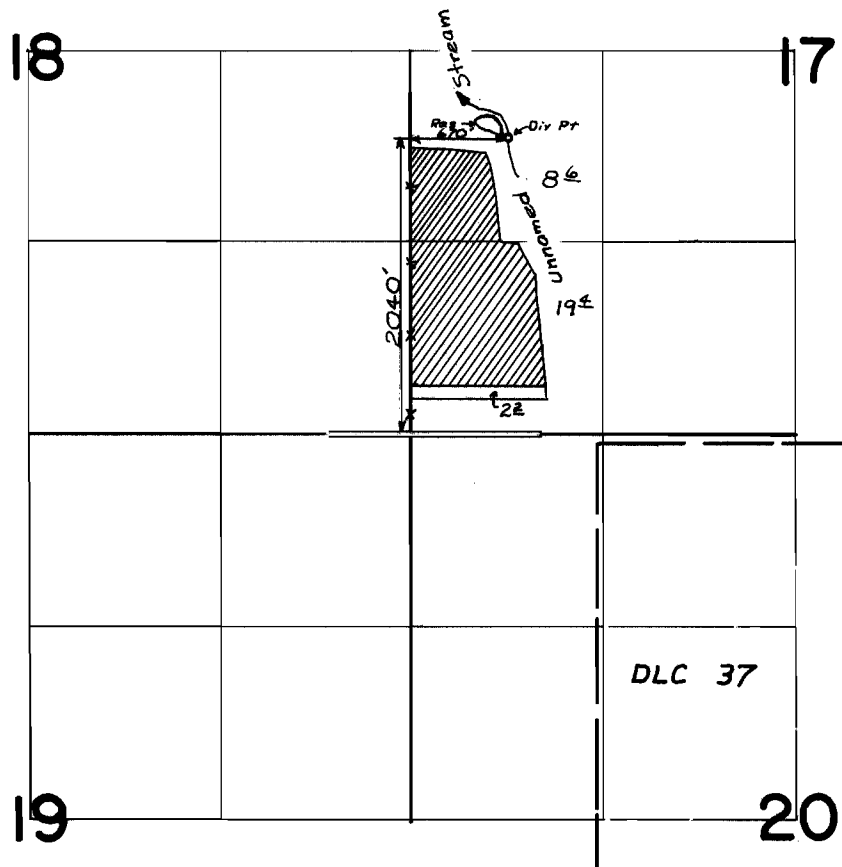

FINAL PROOF SURVEY
UNDER

Application No. R-37976 37977 Permit No. R-3141 28318
IN NAME OF

Robert Sleight

Surveyed Sept. 8, 1967, by W. J. Ruppert