


T.2S.R.I.E.W.M.

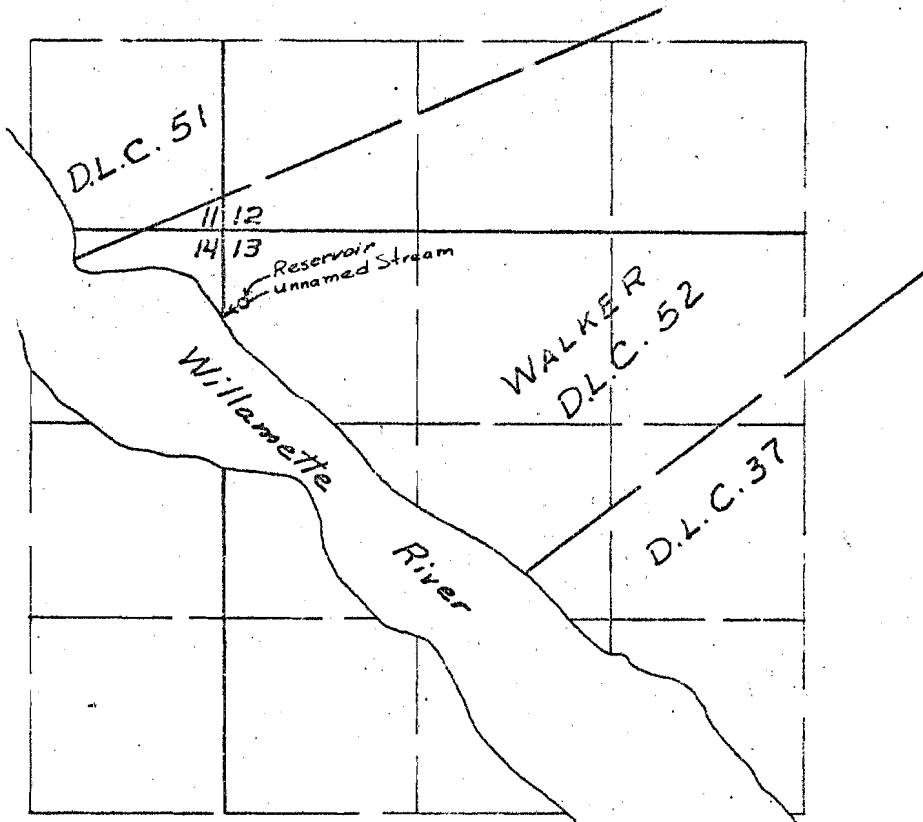

Dir. Pt. located 300ft S. + 1150ft W. from Most Westerly Cor. of Stephen H. Walker DLC 52, being within NW¹/₄ NW¹/₄ Sec. 13

FINAL PROOF SURVEY UNDER

Application No. R-40058 39951 Permit No. R-3983 29733
IN NAME OF

R. W. Rimbach

Surveyed May 31 1967, by W. A. Buppert