


T.5 N. R.2 W. W.M.

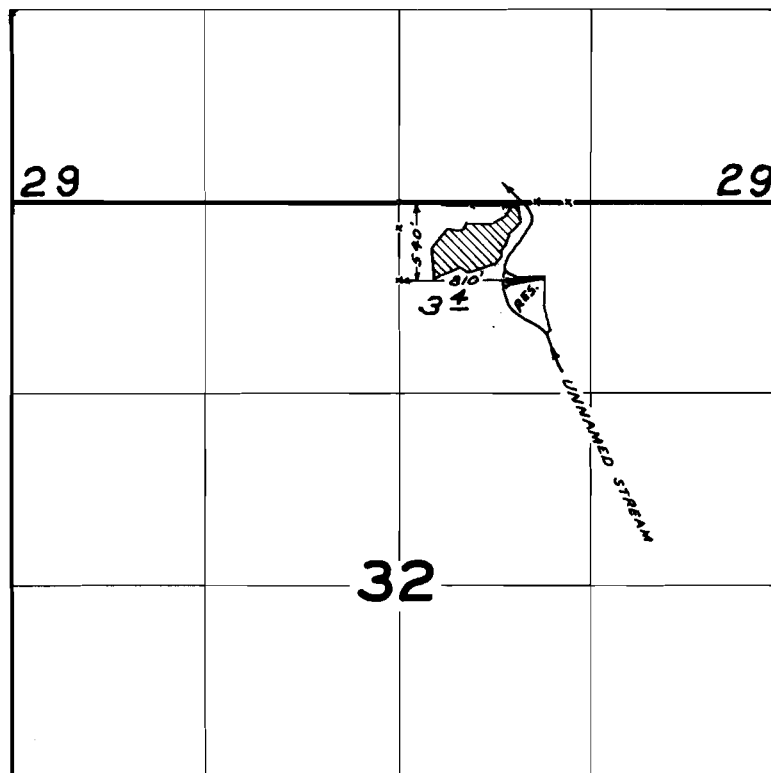

**FINAL PROOF SURVEY**  
UNDER

Application No. R-25713 Permit No. R-1961  
25714 24586  
IN NAME OF

ESTATE OF J. A. DENTON

Surveyed JUL. 17 19.67, by V. GARNER