


T.5 N. R.2 W. W.M.

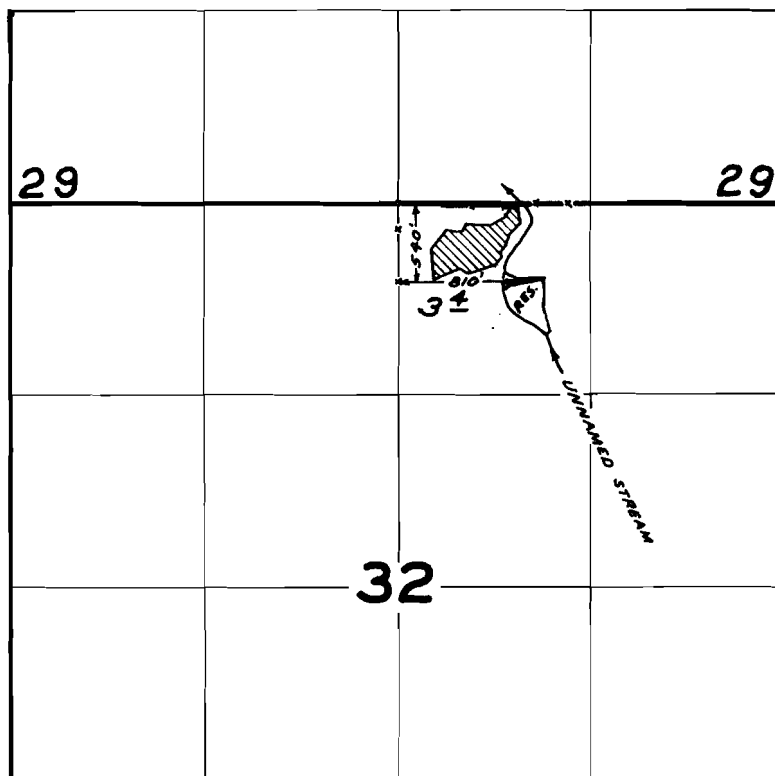

FINAL PROOF SURVEY
UNDER

Application No. R-25713 Permit No. R-1961
25714 24586
IN NAME OF

ESTATE OF J. A. DENTON

Surveyed JUL. 17 1967, by V. GARNER