


T.29S. R.6W. W.M.

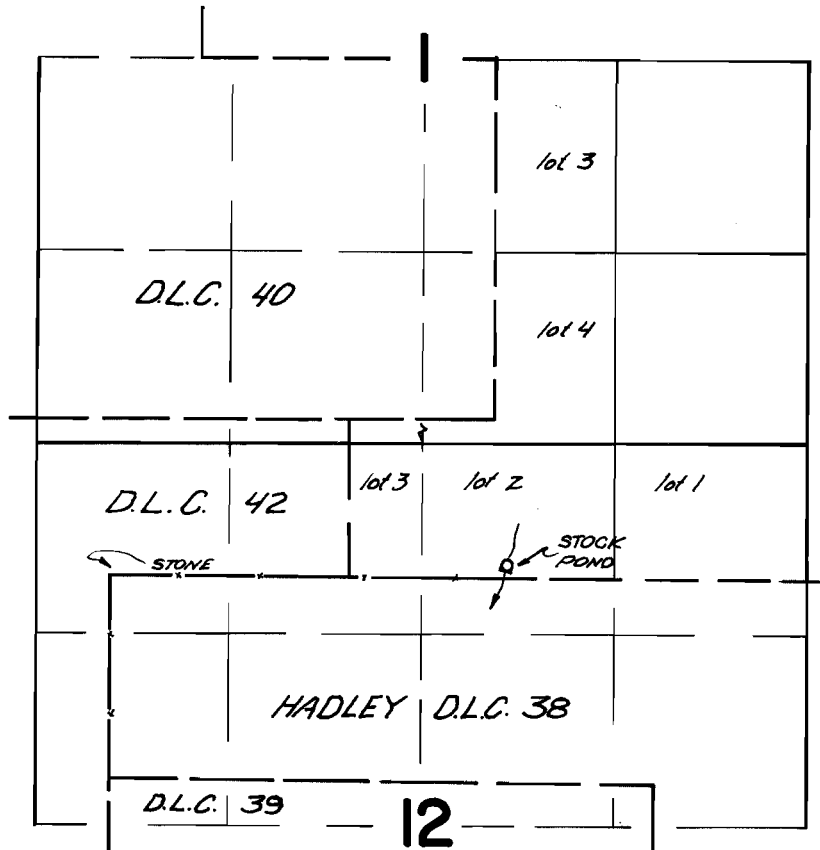

FINAL PROOF SURVEY UNDER

Application No. *R-40498* Permit No. *R4523*
IN NAME OF

JACK ANDERSON

Surveyed *Sept. 21 1967*, by *V. Garner*