


T. 25 S. R. 5 W. W.M.

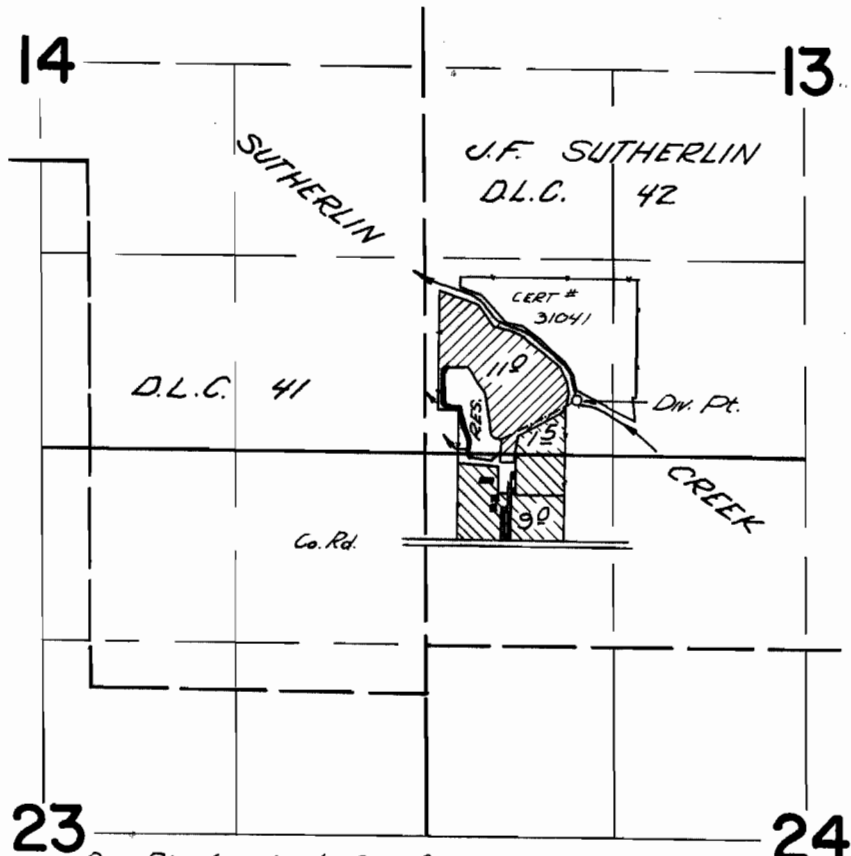

Div. Pt. located 370 feet N. & 1050 feet E.
from the S.W. corner Section 13

FINAL PROOF SURVEY UNDER

35819	27517	
R-35818	R-2650	
38193	28463	
R-38192	R-3164	

Application No. *R-38192* Permit No. *R-3164*

IN NAME OF

IVAN E. HOLM

Surveyed *April 21, 1967*, by *V. Garner*