


T. 22 S. R. 58 & 6 W. W.M.

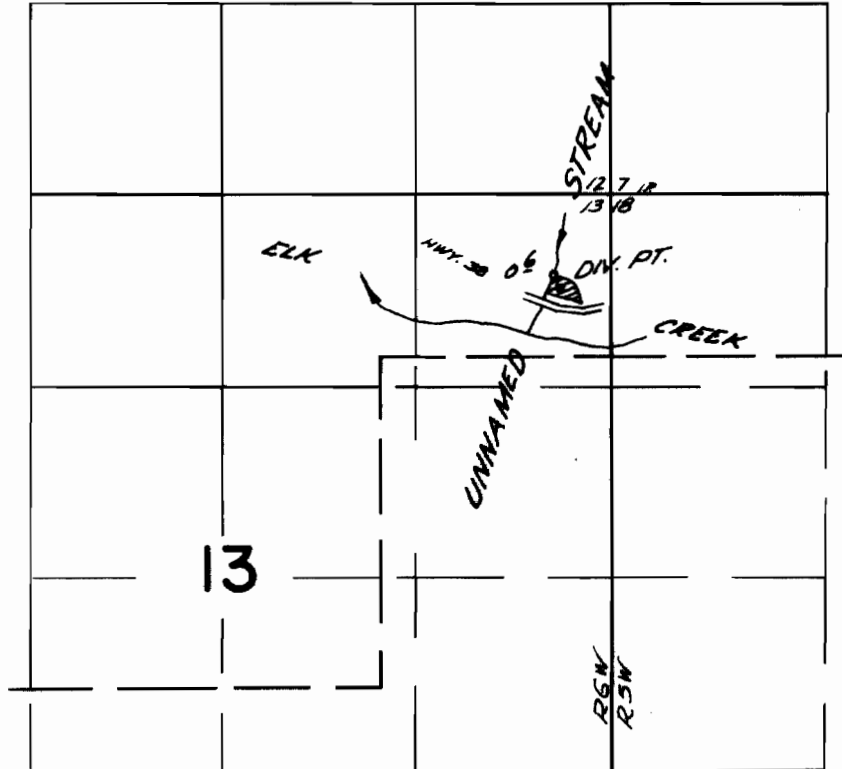

DIV. PT. LOCATED:- 560 FT. S \times 390 FT. W FROM THE NE. COR. S50, 18

FINAL PROOF SURVEY
UNDER

Application No. 41278 Permit No. 30781
IN NAME OF

LENORE C. HUCKINS

Surveyed May 18 1966, by V. Garner