


T29S. R.3W. W.M.

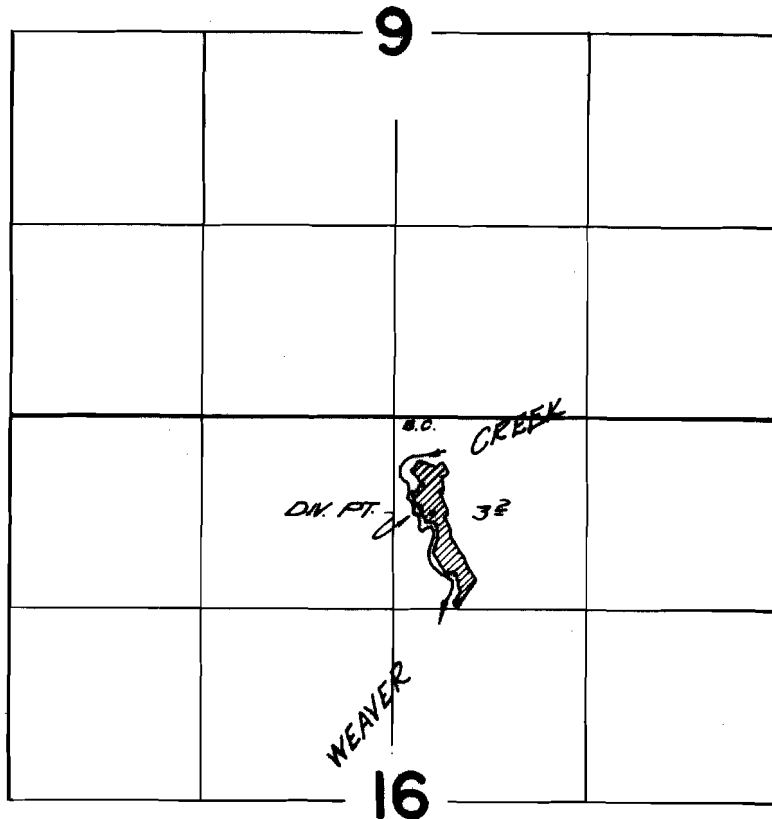

*Div. pt located 630 ft. S. and 160 ft. E.
from the N & corner of section 16*

FINAL PROOF SURVEY UNDER

Application No. *42164* Permit No. *31553*
IN NAME OF

LAWRENCE T. and GIDRIA A. COOMBES

Surveyed *Sept. 20 1967*, by *V. Garner*