


T.14S. R.29E.W.11

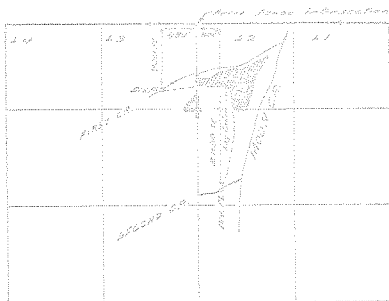

FINAL PROOF SURVEY UNDER

Application No. 31591, Permit No. 27376
IN NAME OF

Una Pope

Surveyed June 24 1967 by *W. J. Appert*