


# T.13S. R.28E. W.M.

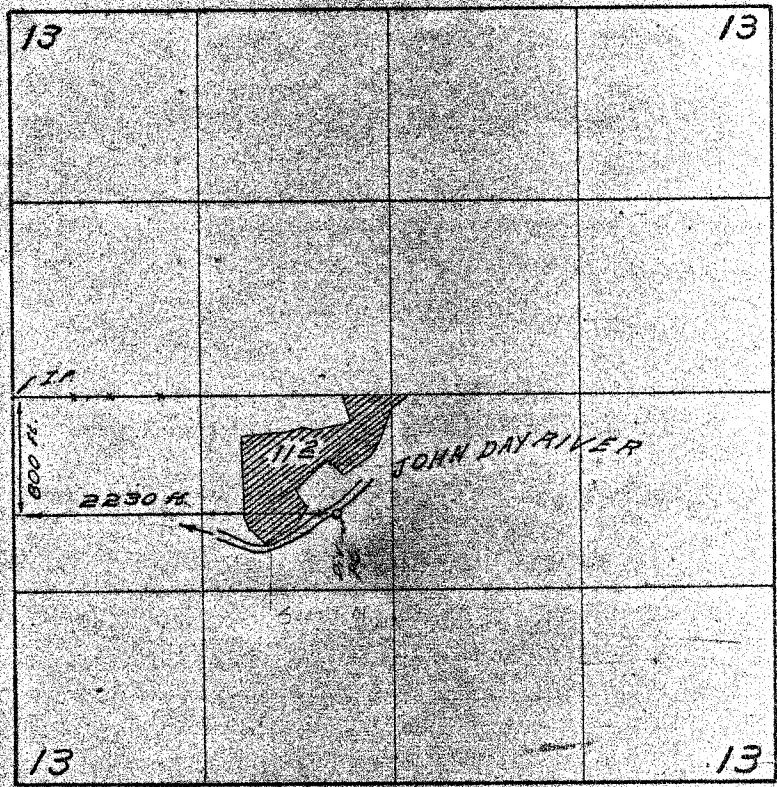

## FINAL PROOF SURVEY UNDER

Application No. 37211 Permit No. 27730  
IN NAME OF

*Herman John Michael*

Surveyed June 22 1967, by *W.S. Ruppert*