


P-30168

35130

T. 18 S. R. 28 E. W.M.

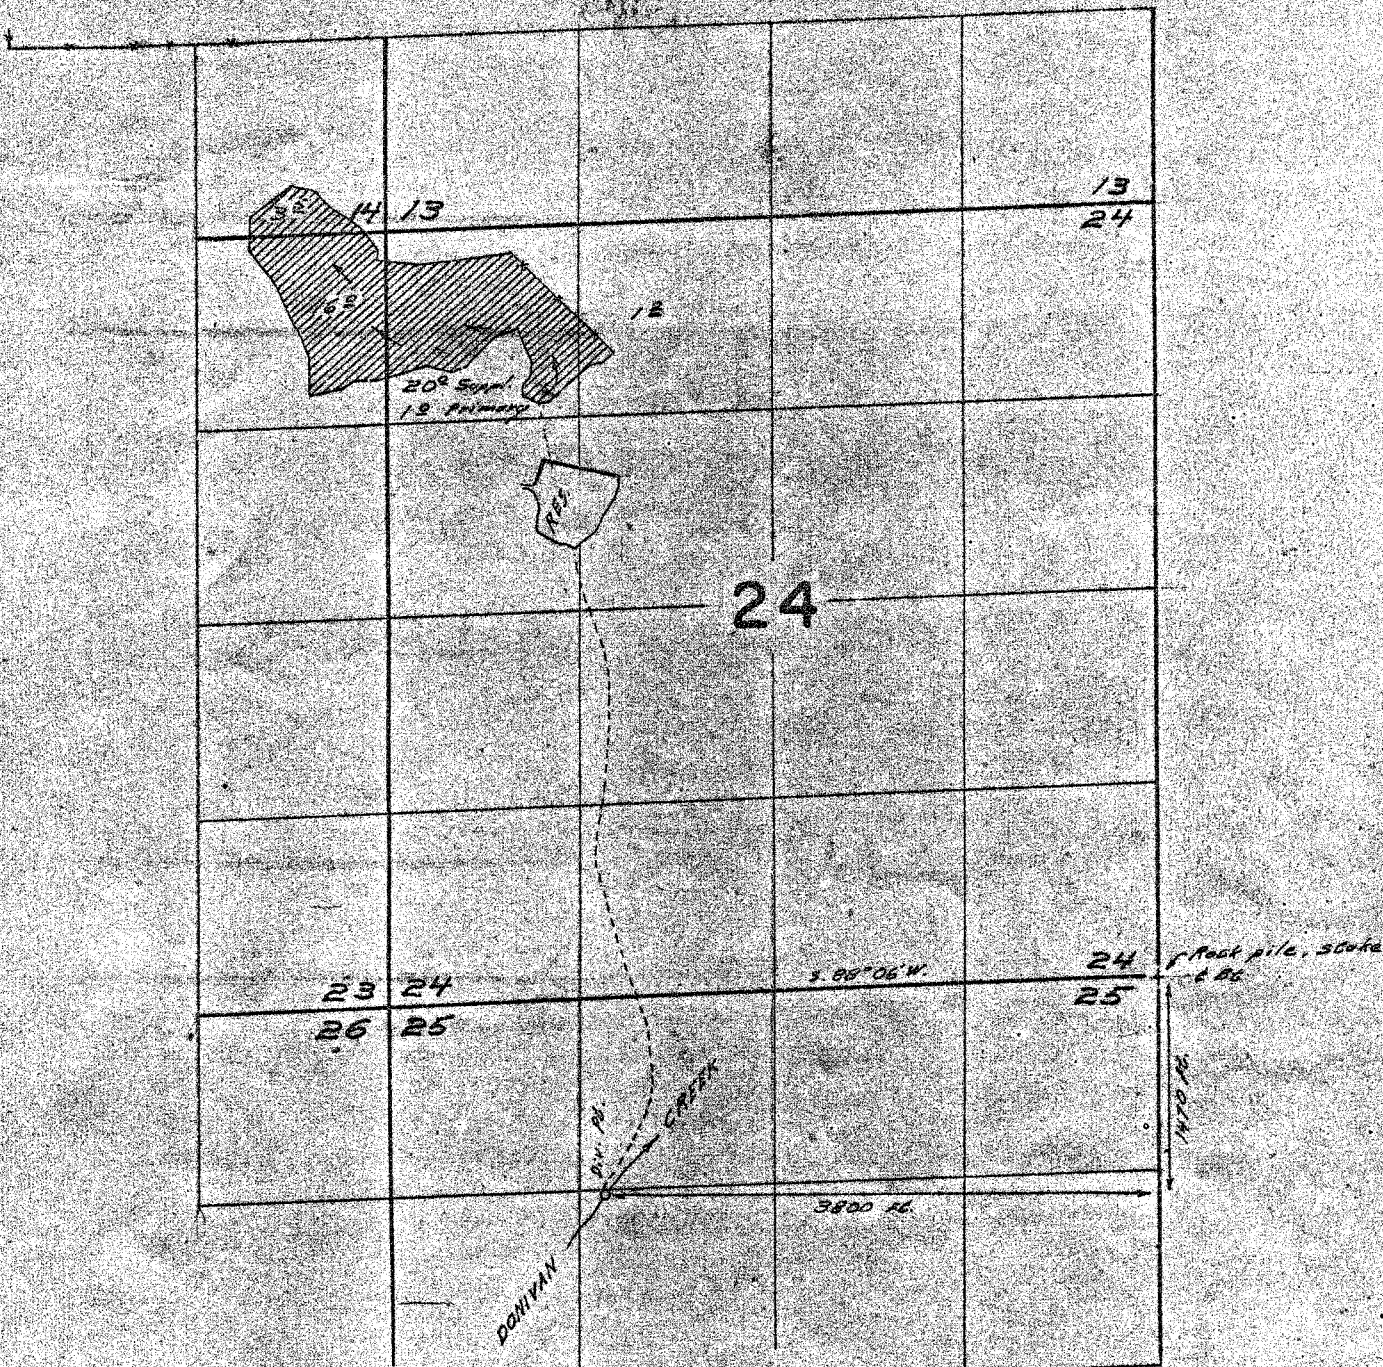

FINAL PROOF SURVEY

UNDER

R-40484

P-4521

Application No. 40485 Permit No. 30168

IN NAME OF

Abe Rickman

Surveyed July 21 1966, by J. J. Ruppert
June 23 67

June 23 67