P-R4521 6
P-30168

35130

T. 18 S. R. 28 E. W.M.

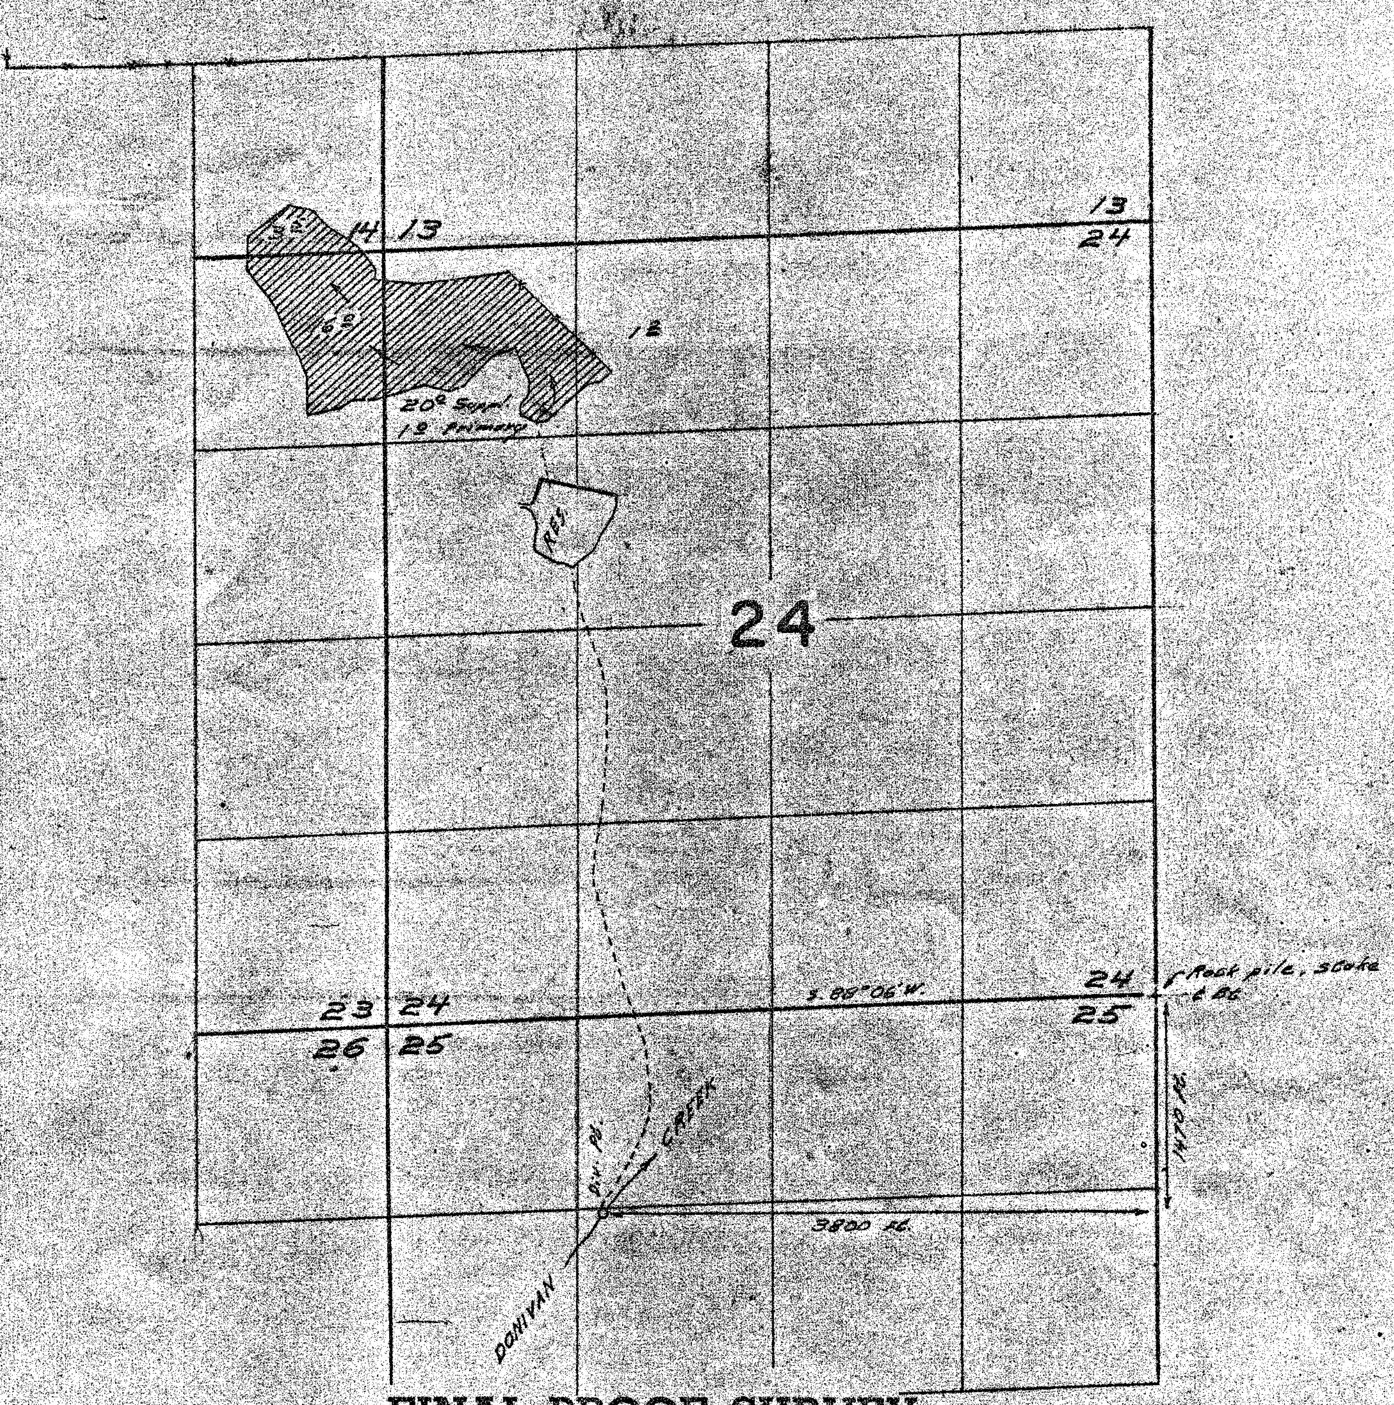

FINAL PROOF SURVEY

UNDER

R-40484 R-4521
Application No. 40485. Permit No. 30168.

IN NAME OF

Abe Rickman

Surveyed July 21 1966, by H.J. Ruppert
June 23 67