


T. 18 S. R. 30 E. W. M.

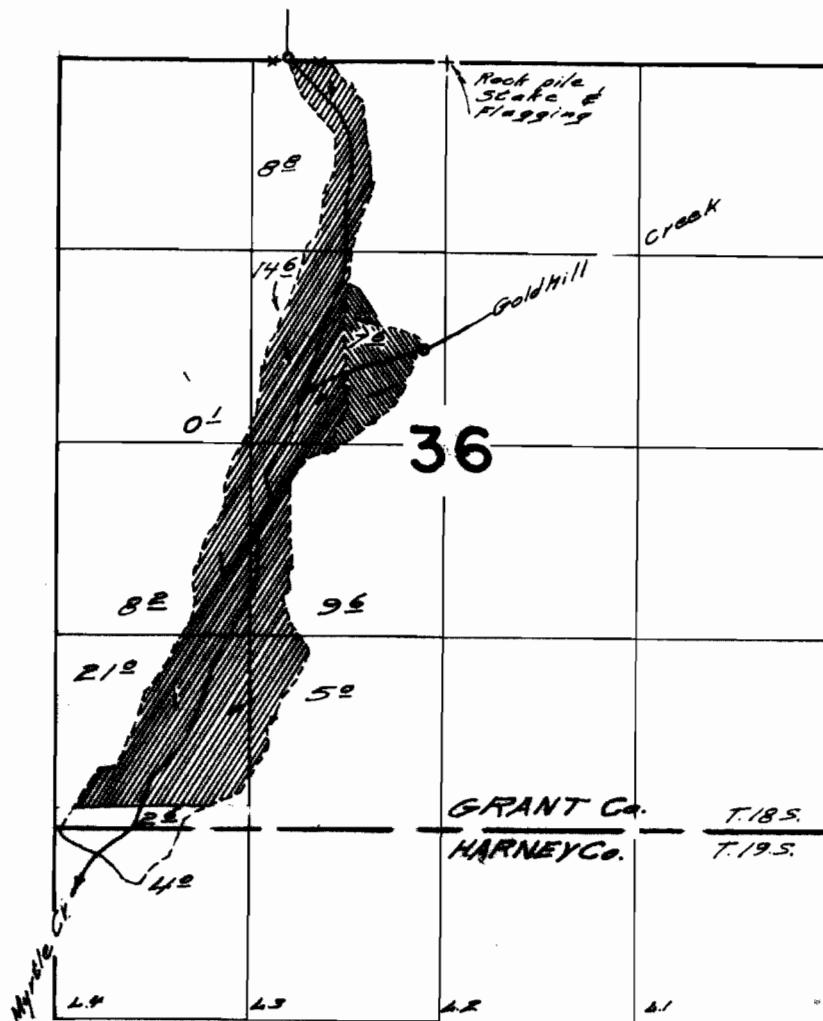

Diversion point from Myrtle Creek 20 ft. N. & 1080 ft. W.
Diversion point from Gold Hill Creek 1970 ft. S. & 440 ft. W.
Both from N 1/4 Cor Sec 36

FINAL PROOF SURVEY
UNDER

Application No. 41256.. Permit No. 30766
IN NAME OF

C. W. CLEMENS

Surveyed Aug. 3, 1967, by W. D. PURPERS