


T. 22 S. R. 30 E. W.M.

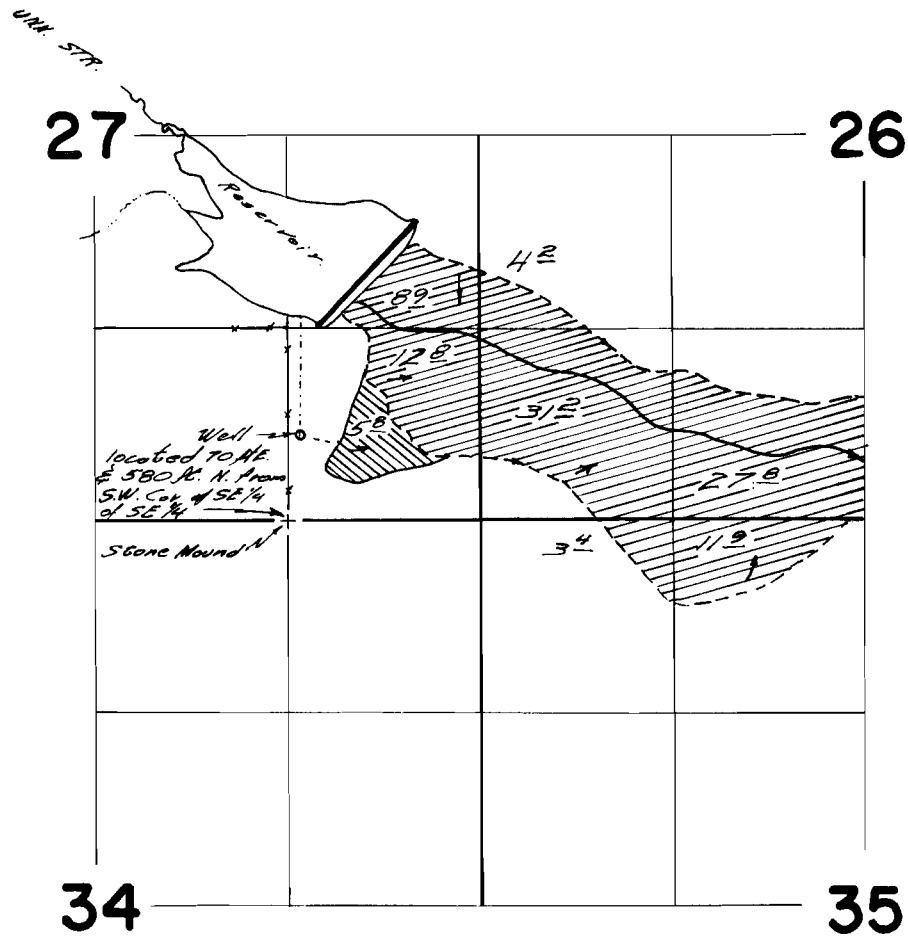

SUPPLEMENTAL to CERT. # 28850



PRIMARY

FINAL PROOF SURVEY
UNDER

Application No. G-2088 Permit No. G-1917
IN NAME OF

Werner W. Arntz

Surveyed Aug 1 1967, by W. J. Pappert