


T. 23 S. R. 32 E. W. M.

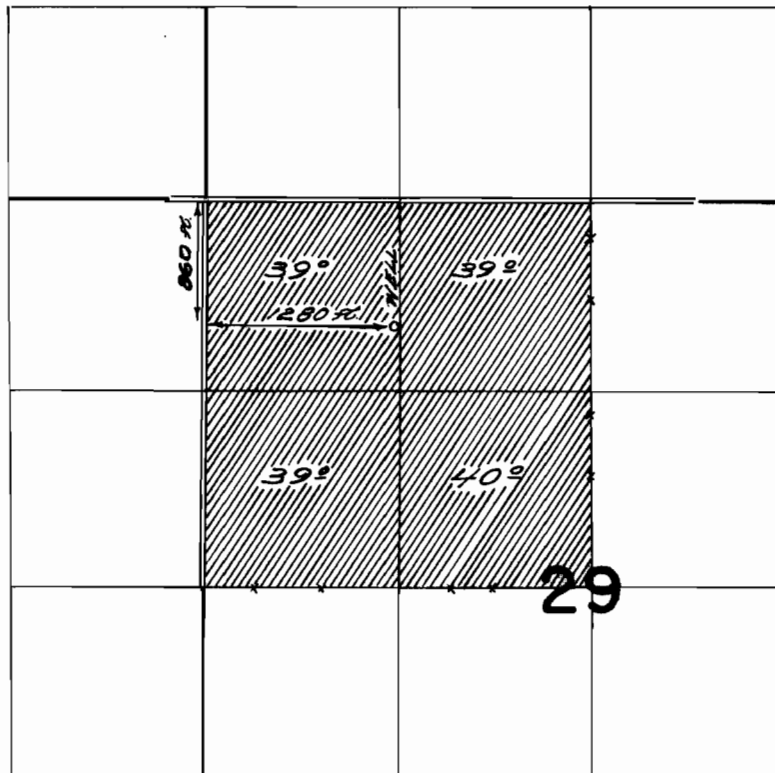

FINAL PROOF SURVEY
UNDER

Application No. ~~G-2296~~ Permit No. ~~G-2117~~
IN NAME OF

Rye Grass Ranches

Surveyed July 25, 1967, by *W. J. Ruppert*