


T. 23 S. R. 31 E. W. M.

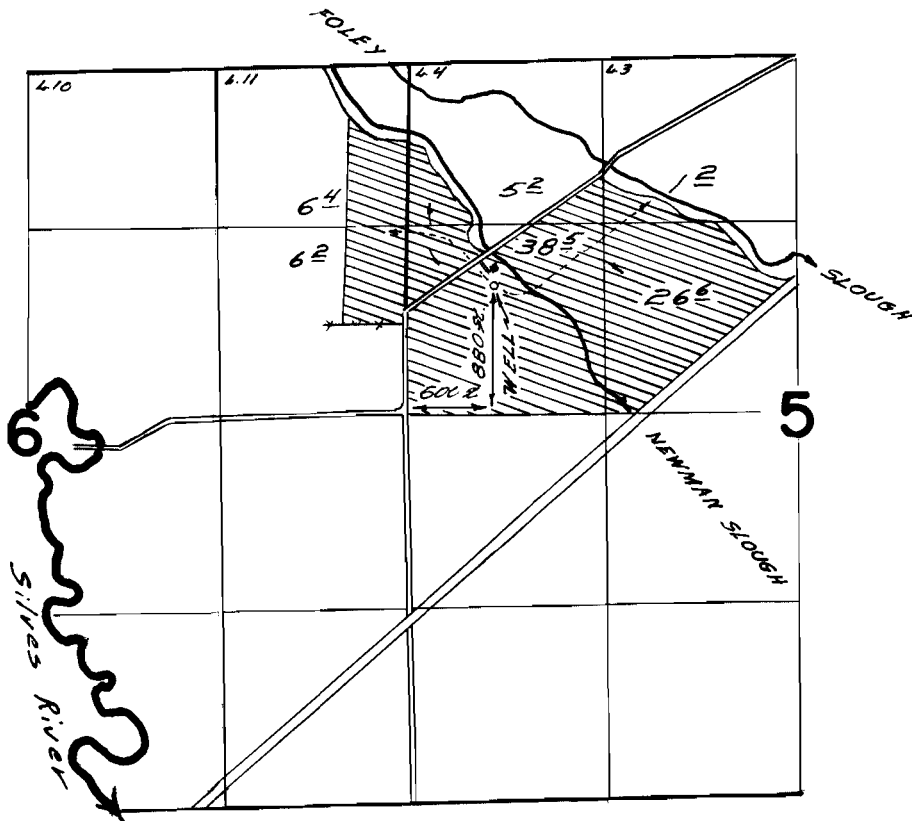

FINAL PROOF SURVEY
UNDER

Application No. G-2418 Permit No. G-2234
IN NAME OF

Eben Ray

Surveyed July 28, 1967, by Ed. Ruppert