


T. 23 S. R. 32 E. W. M

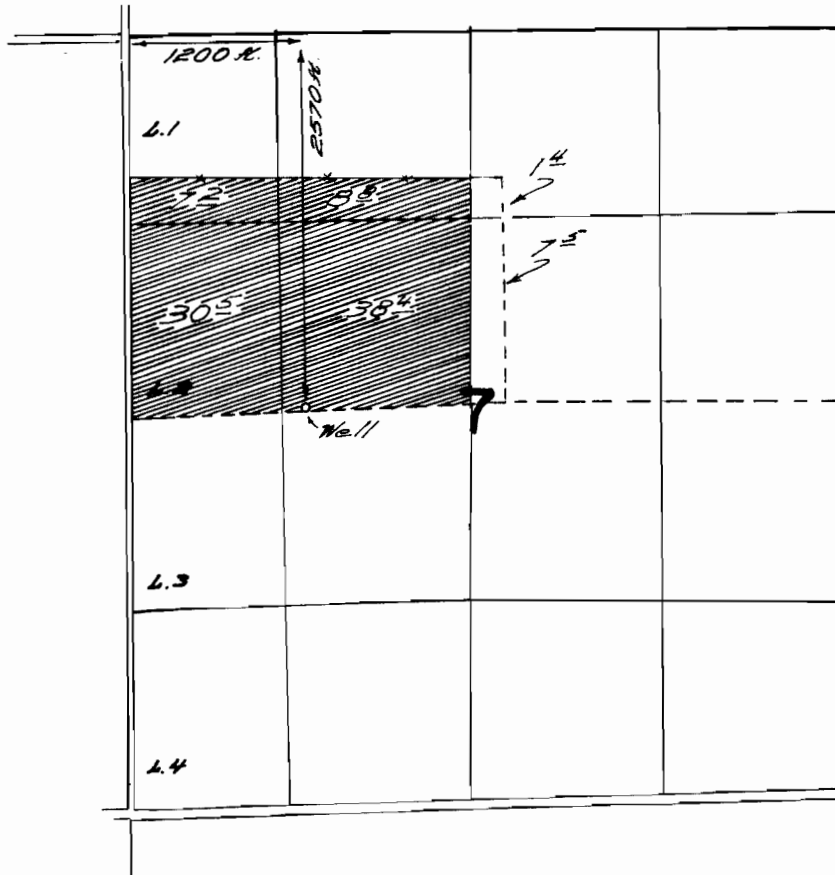

FINAL PROOF SURVEY UNDER

Application No. ~~G-2526~~ Permit No. ~~G-2341~~
IN NAME OF

Huber Ray

Surveyed Aug. 2, 1967, by *W.D. Rupperts*