


T. 22 S. R. 33 E. W.M.

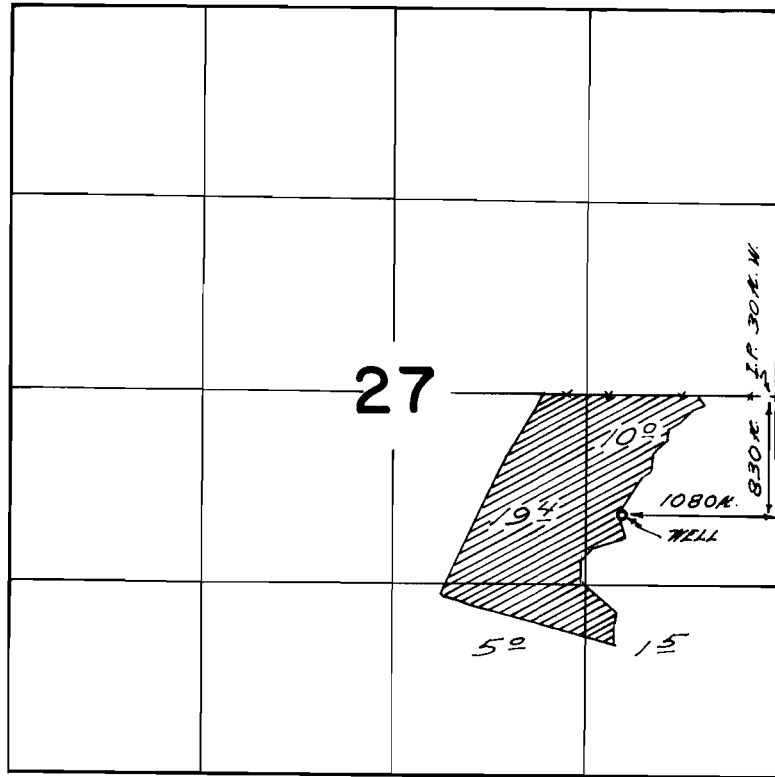

FINAL PROOF SURVEY
UNDER

Application No. *G-2595* Permit No. *G-2402*
IN NAME OF

John E Temple

Surveyed *Aug 2* 1967, by *Wd. Ruppert*