


T. 22 S. R. 31 E. W.M.

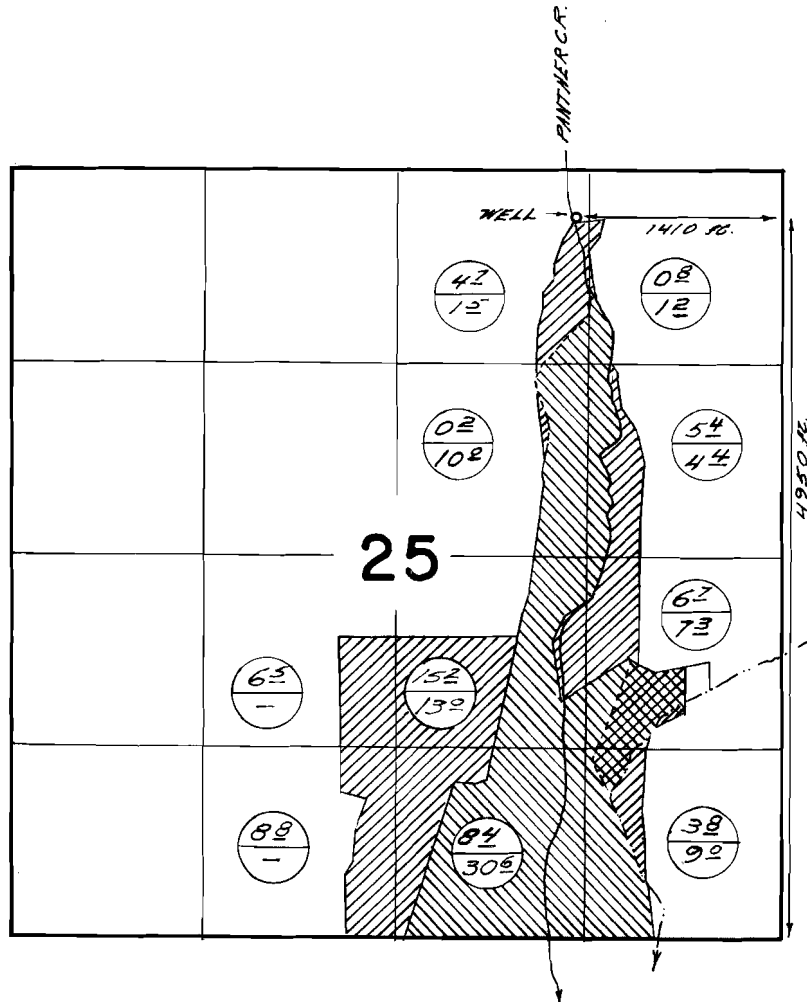

 PRIMARY  SUPPLEMENTAL
 To  Cert # 20247 &  Cert # 20246

FINAL PROOF SURVEY UNDER

Application No. G-302 Permit No. G-2810
IN NAME OF

Tyler Brothers

Surveyed July 28 1967, by W.J. Ruppert