


T. 23 S. R. 30 & 31 E. W.M.

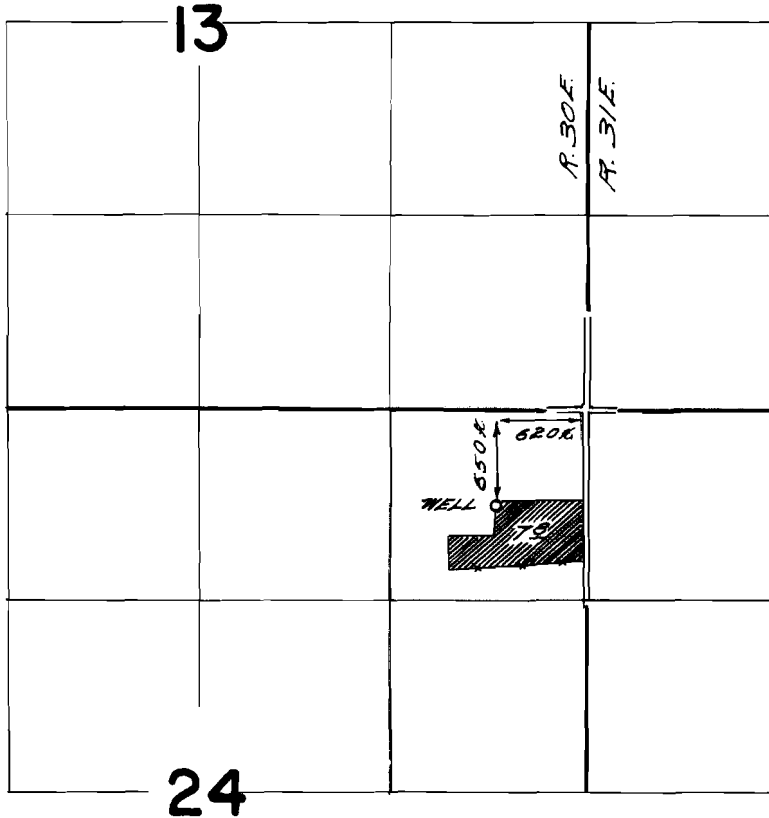

**FINAL PROOF SURVEY**  
UNDER

Application No. G-3050 Permit No. G-2846  
IN NAME OF

Harney Co. Fair Assoc.

Surveyed Aug 2, 1967, by N. V. Ruppert.