


T. 19 S. R. 34 E. W.M.

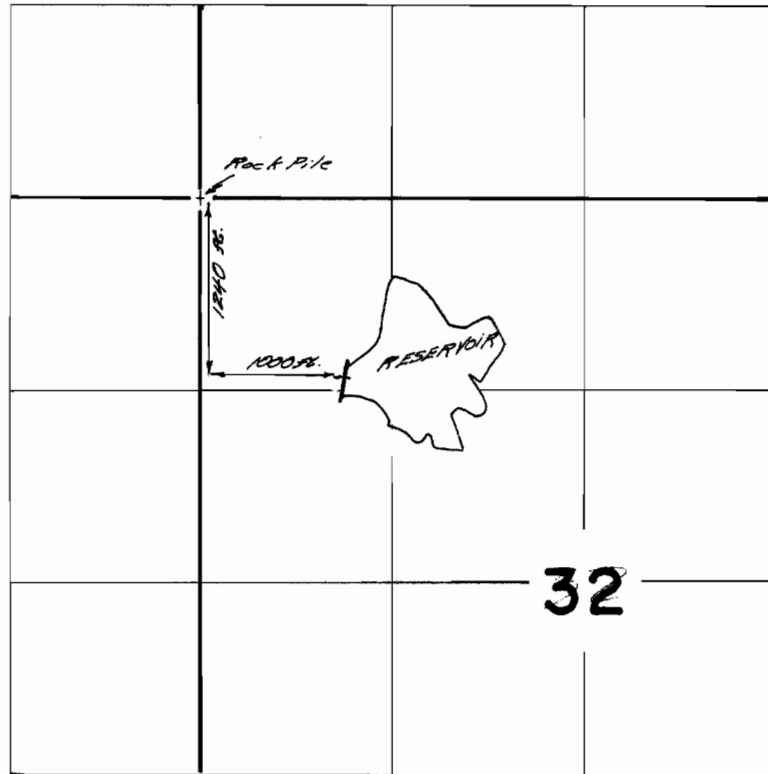

FINAL PROOF SURVEY
UNDER

Application No. *P-38213* Permit No. *P-3166*
IN NAME OF

V. Dash Cattle Co.

Surveyed *July 26, 1967*, by *W.D. Fugger*