


T. 22 S. R. 32 E. W. M.

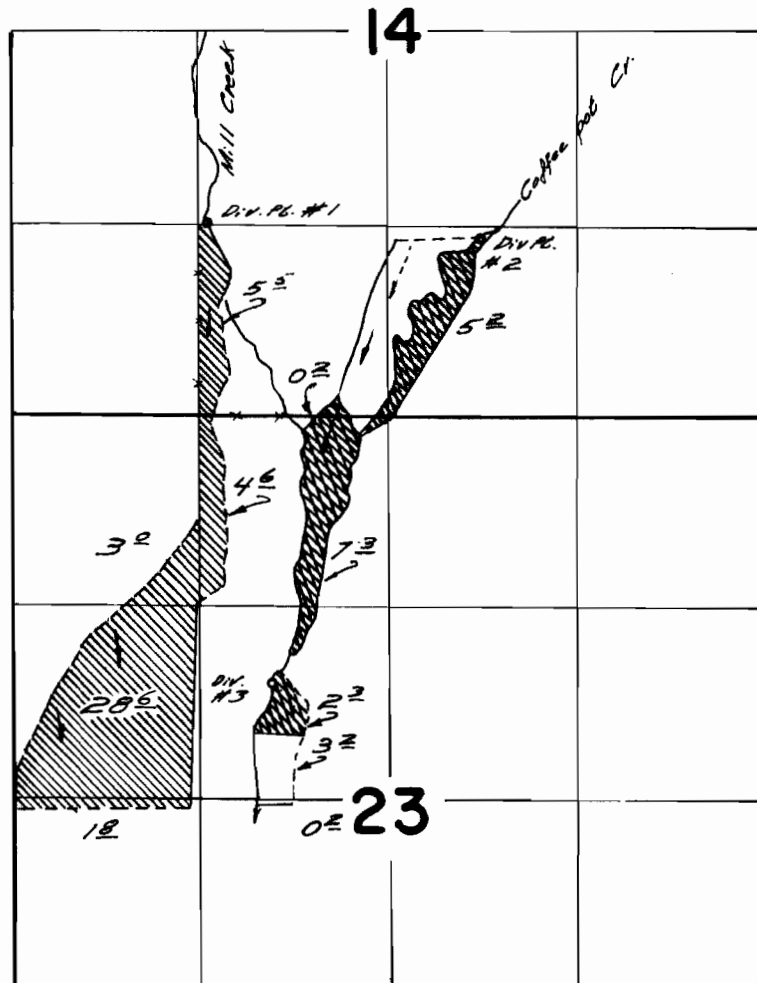

Div. Pl. #1 1330 N. N. & 70 N. E.; #2 1220 N. N. & 1930 N. E.;
 & #3 1840 N. S. & 480 N. E. from S.W. Corner SE 1/4 SW 1/4

FINAL PROOF SURVEY UNDER

Application No. 33142 Permit No. 26208
 IN NAME OF

Ralph E Reed

Surveyed July 27 1967, by W. J. Ruggard