


T.39 S.R.5 W.W.M.

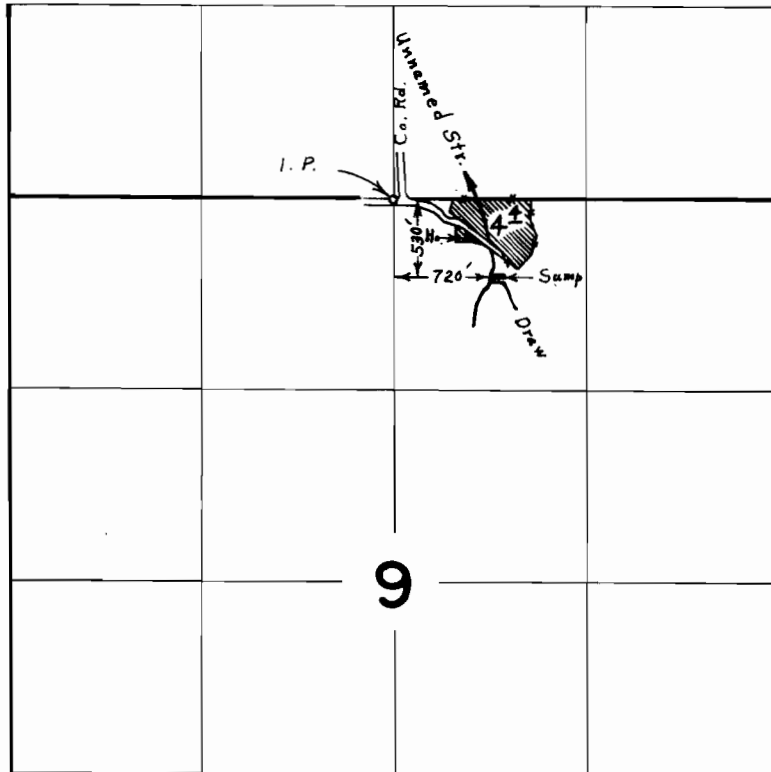

**FINAL PROOF SURVEY**  
UNDER

Application No. G-2632 Permit No. G-2455  
IN NAME OF  
**JIM C. COLEMAN**

Surveyed Aug. 22, 1967., by L. E. Gould