



T.40S. R.8W. W.M.

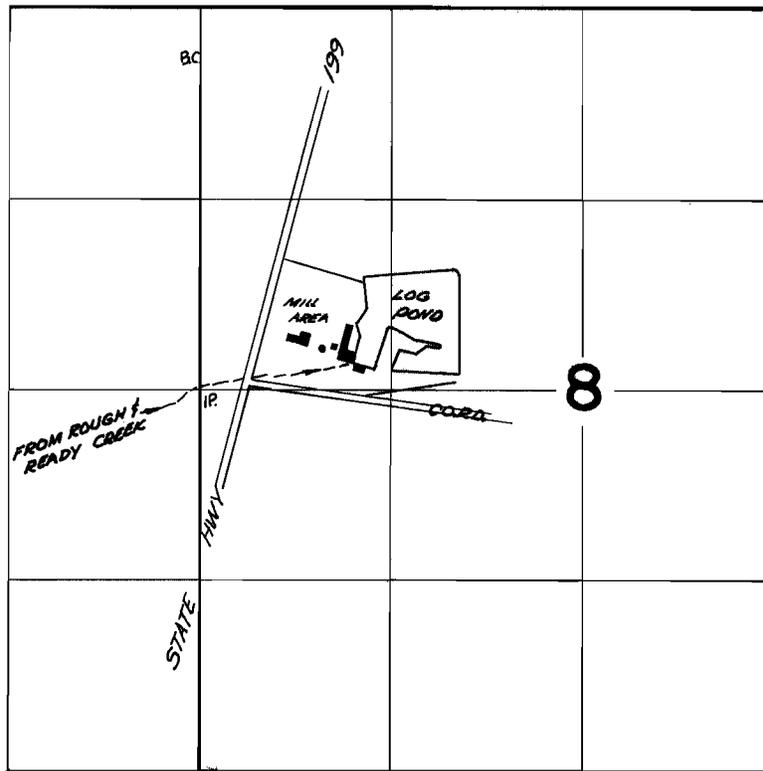

T.40S. R.9W. W.M.

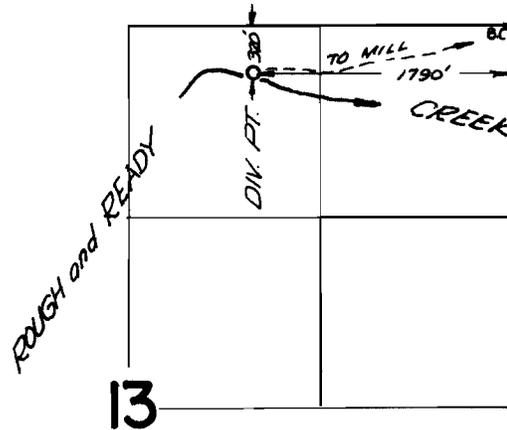

FINAL PROOF SURVEY UNDER

38525 29196
Application No. R.38583 Permit No. R.3881
IN NAME OF

ROUGH and READY LUMBER CO.

Surveyed May 18 1967, by V. Garner