

FINAL PROOF SURVEY


UNDER

APPLICATION NO. U-319, PERMIT NO. U-343

IN NAME OF

**NEVIN CATTLE CO.
GENE & VERA L. CARL
MIKE & BESSIE SHORT**

SURVEYED OCT. 6, 1965 BY R. JACKSON
JUN. 28, 1967 BY V. GARNER

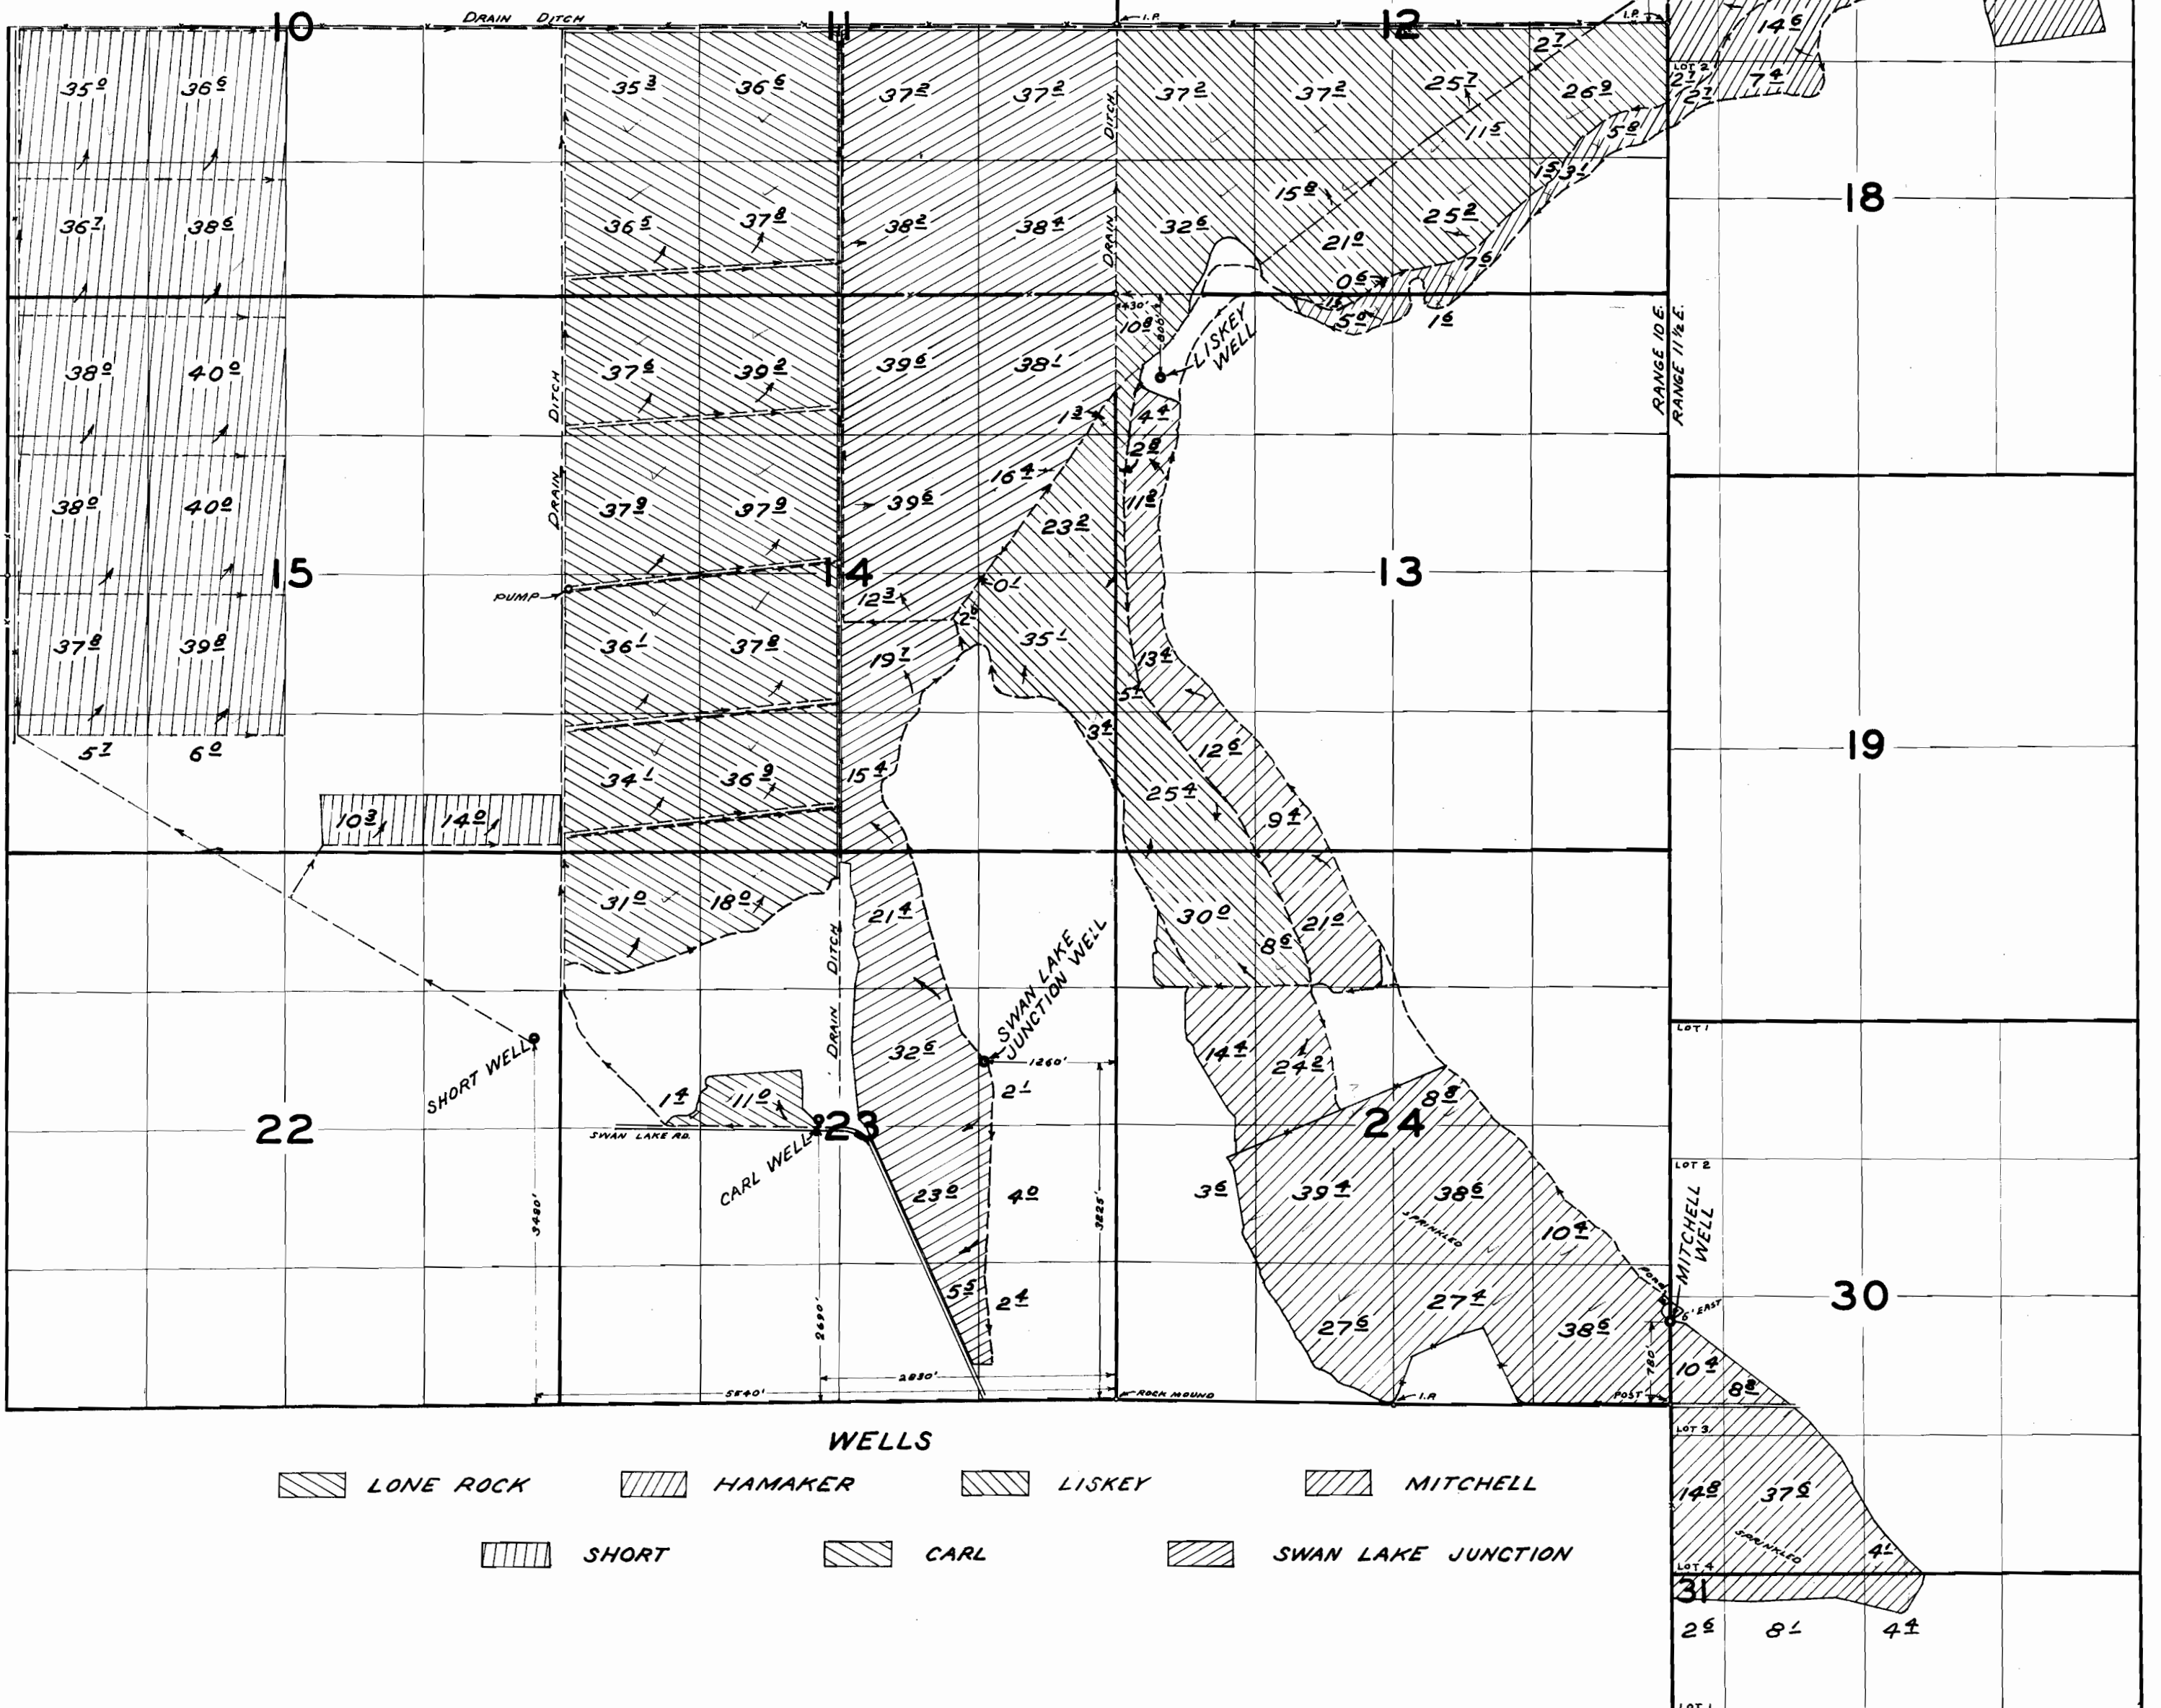

WELLS

- | | | | | | | | |
|--|-----------|--|---------|--|--------------------|--|----------|
| | LONE ROCK | | HAMAKER | | LISKEY | | MITCHELL |
| | SHORT | | CARL | | SWAN LAKE JUNCTION | | |