


28858
35153

T.33&34S.R.7½E.W.M.

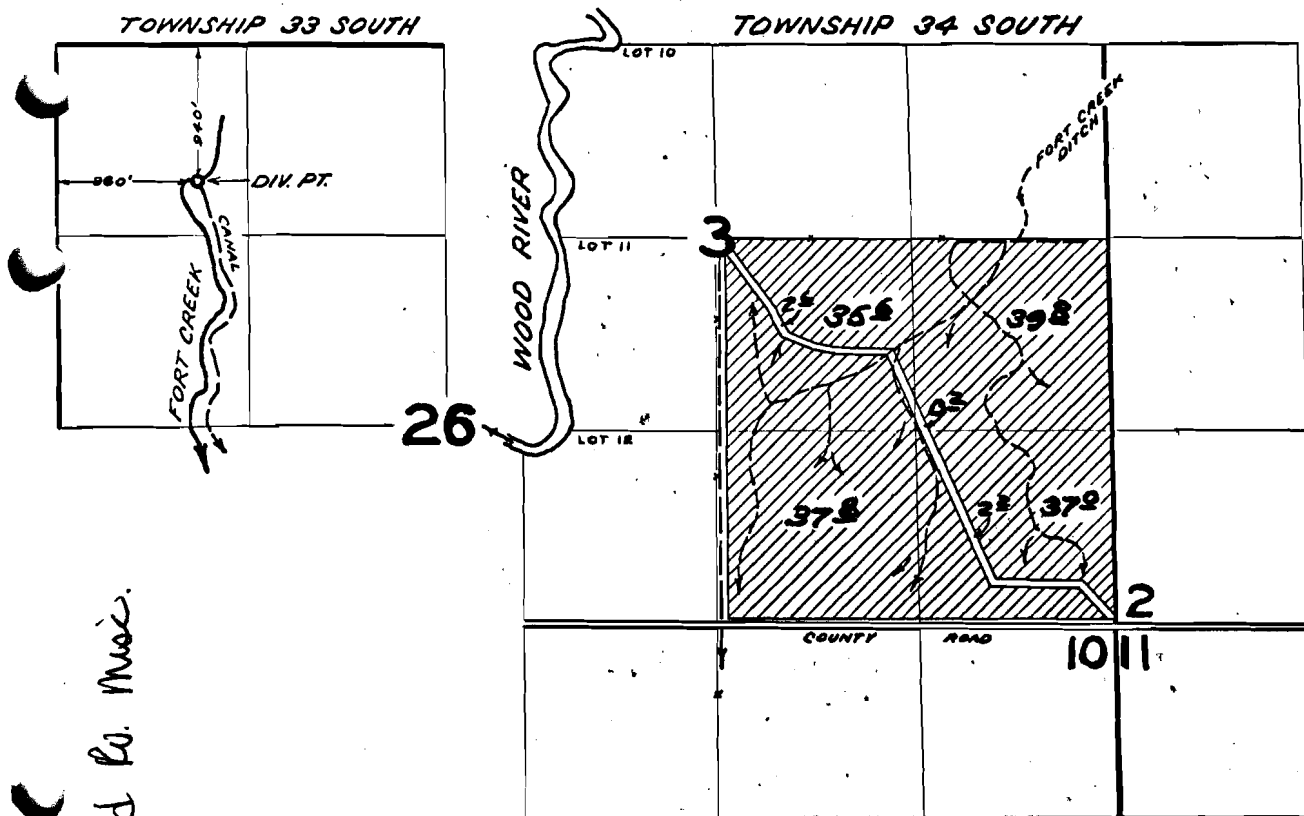


FINAL PROOF SURVEY UNDER

Application No. 38803 Permit No. 28858
IN NAME OF

LLOYD G. AND DOROTHY M. NICHOLSON

Surveyed JUN. 28, 1967, by V. GARNER