


13
~~211~~
32182
35155

T. 38 S. R. 20 E. W.M.

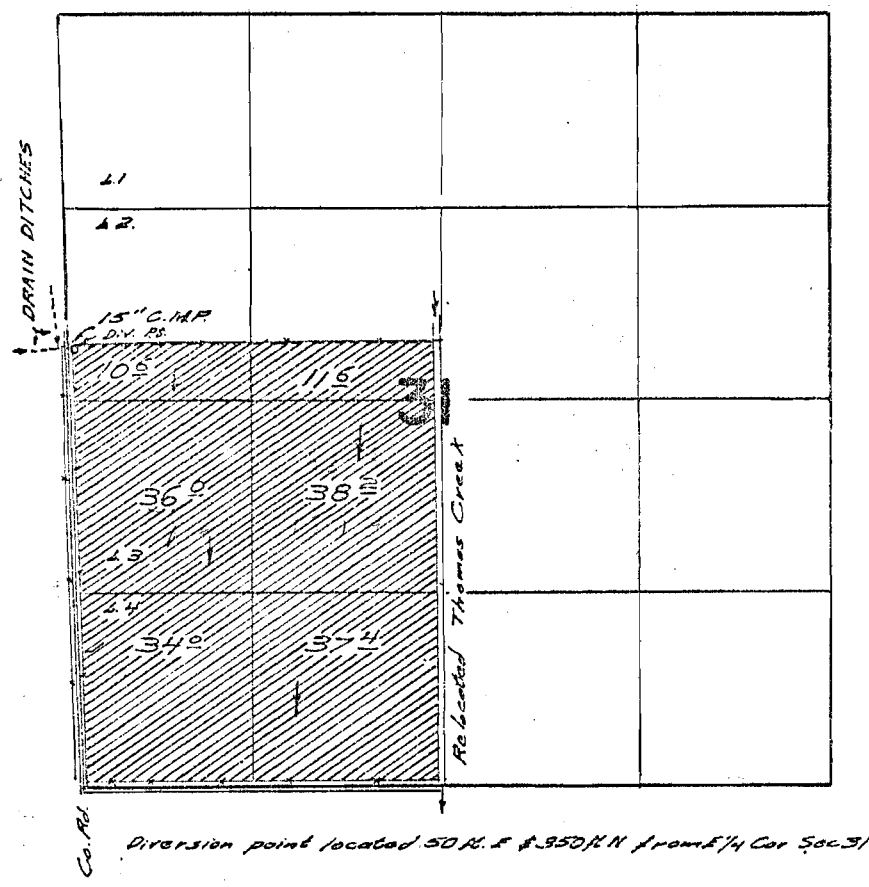

FINAL PROOF SURVEY UNDER

Application No. 43073 Permit No. 32182
IN NAME OF

ERWIN ABRAMSON

Surveyed Aug 31, 1967 by W.D. Puppert

38-20 ✓