


T.19S.R.1W.W.M.

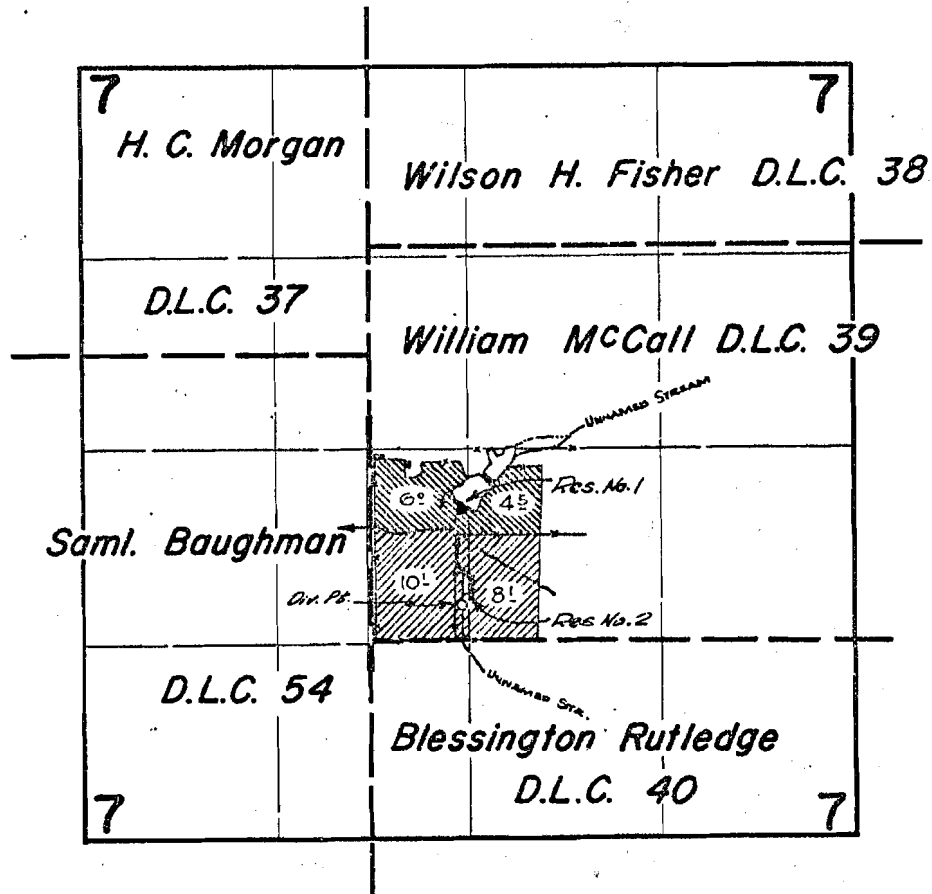

Diversion points located 240 ft. N & 630 ft. E; & 320 ft. N
& 630 ft. E; both from S.W. corner McCall D.L.C. 39

FINAL PROOF SURVEY
UNDER

R-34690 R-2593
Application No. 34691... Permit No. 27256....
IN NAME OF

FAWN T. & IRENE C. ANDERSON

Surveyed April 28 1965, by *R. J. Jackson*