


T. 16 S. R. 1 W. W.M.

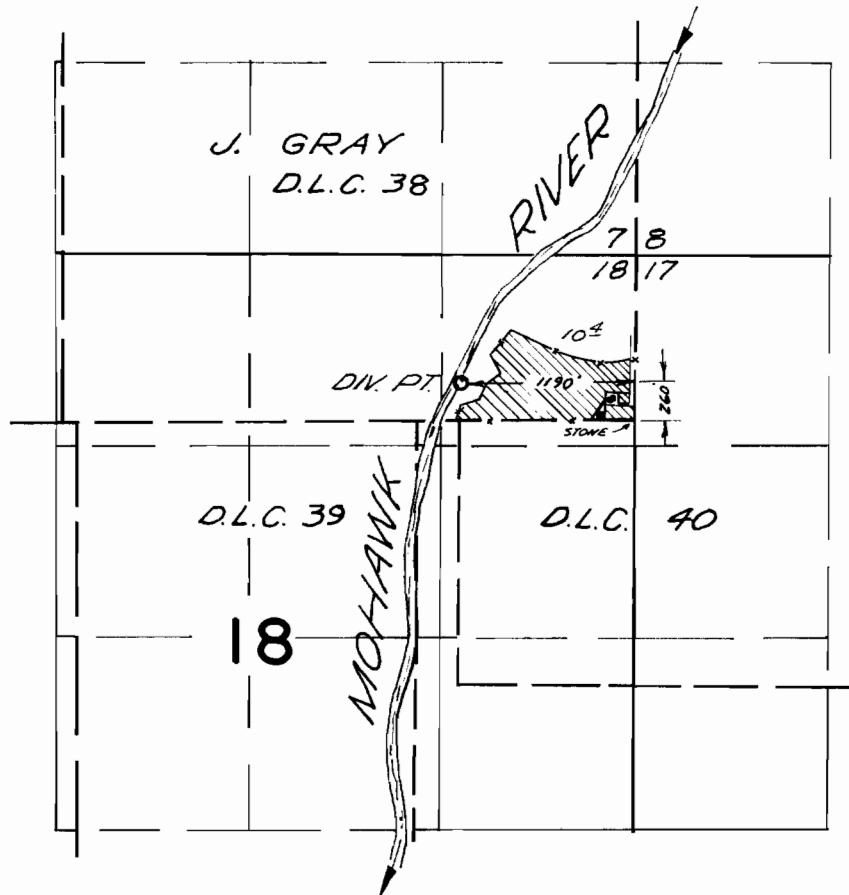

FINAL PROOF SURVEY
UNDER

Application No. 37603 Permit No. 28043
IN NAME OF

MYRON DOYLE

Surveyed May 11, 1959 by V. GARNER