


T.16S.R.6W.W.M.

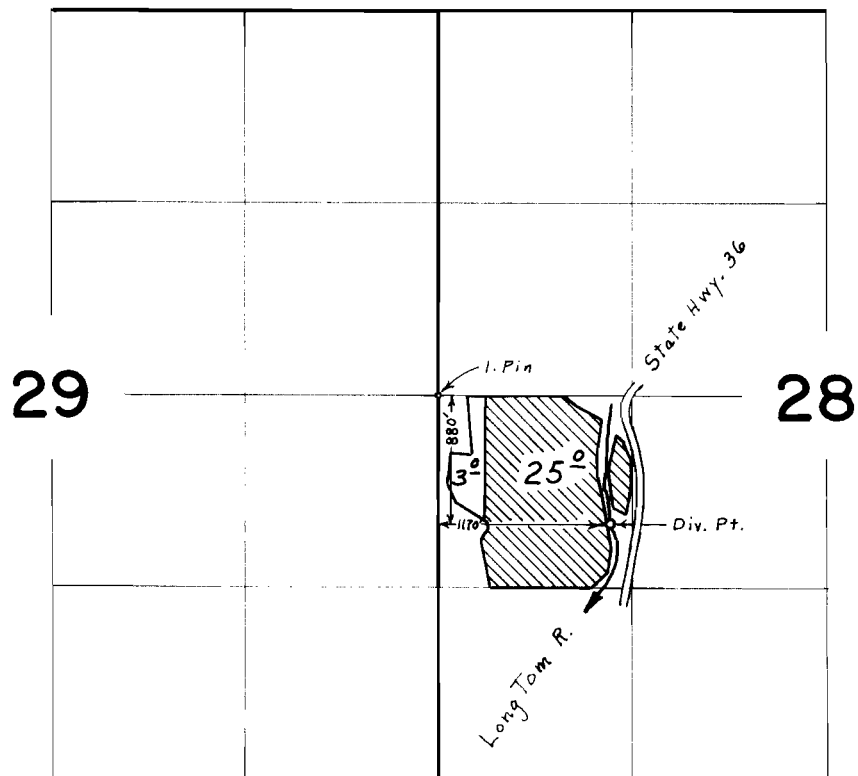

FINAL PROOF SURVEY
UNDER

Application No. 41120 Permit No. 30656
IN NAME OF
PAUL V. TEMPLETON

Surveyed May 11, 1967, by L. E. Gould.