


T.5&6S.R.2W.W.M.

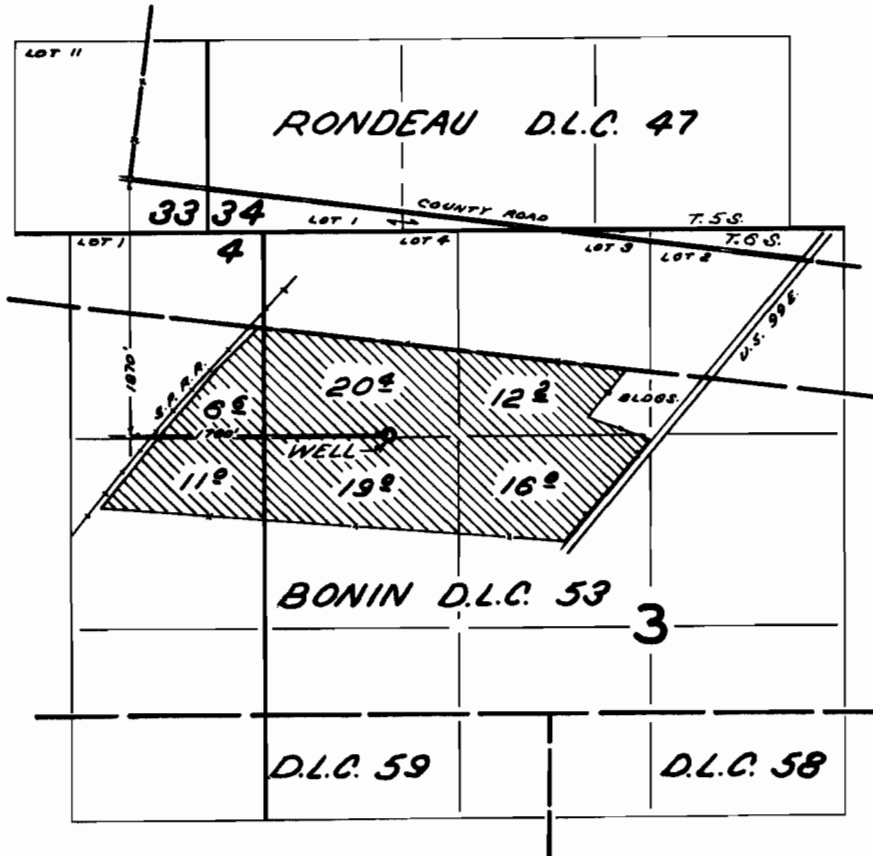

FINAL PROOF SURVEY UNDER

Application No. G-3078 Permit No. G-2865
IN NAME OF

EDWIN C. JOHNSON

Surveyed Nov. 22, 1967, by W.J. RUPPERT