


T. 5 S. R. 1 W. W. M.

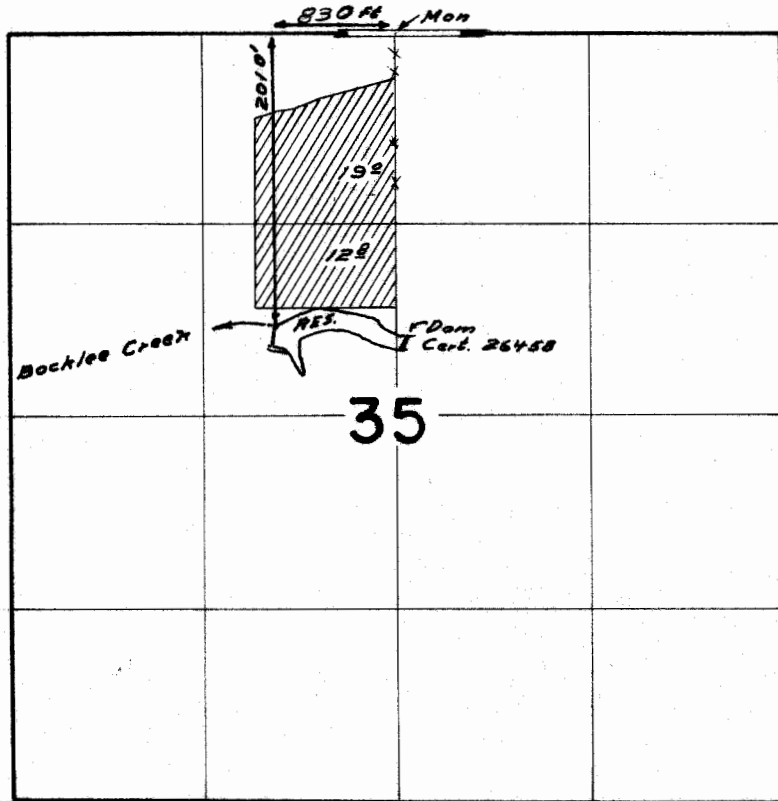

FINAL PROOF SURVEY
UNDER

Application No. R-37966 Permit No. R-3000
37967 28163
IN NAME OF

Edward J. Zach

Surveyed Sept. 8 1966, by W.J. Ruppert