T. 9 S. R. 4 W. W. M.

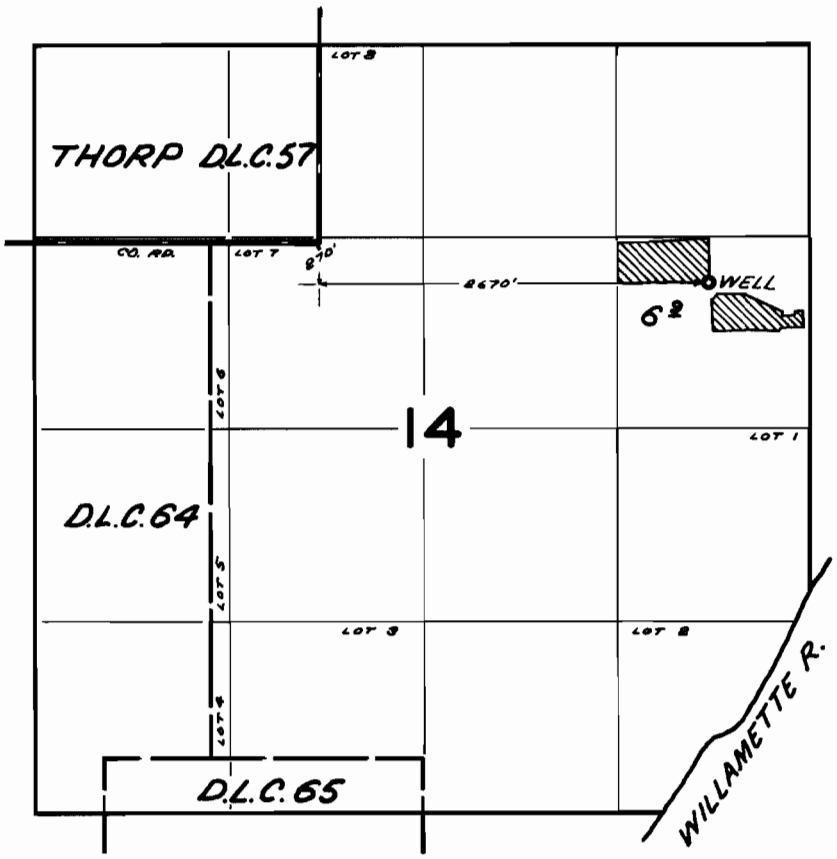

FINAL PROOF SURVEY
UNDER

Application No. G-2623 Permit No. G-2452
IN NAME OF

HENRY C. MODE

Surveyed MAR. 31 1967, by W. J. RUPPERT