


T.9S.R.4 W.W.M.

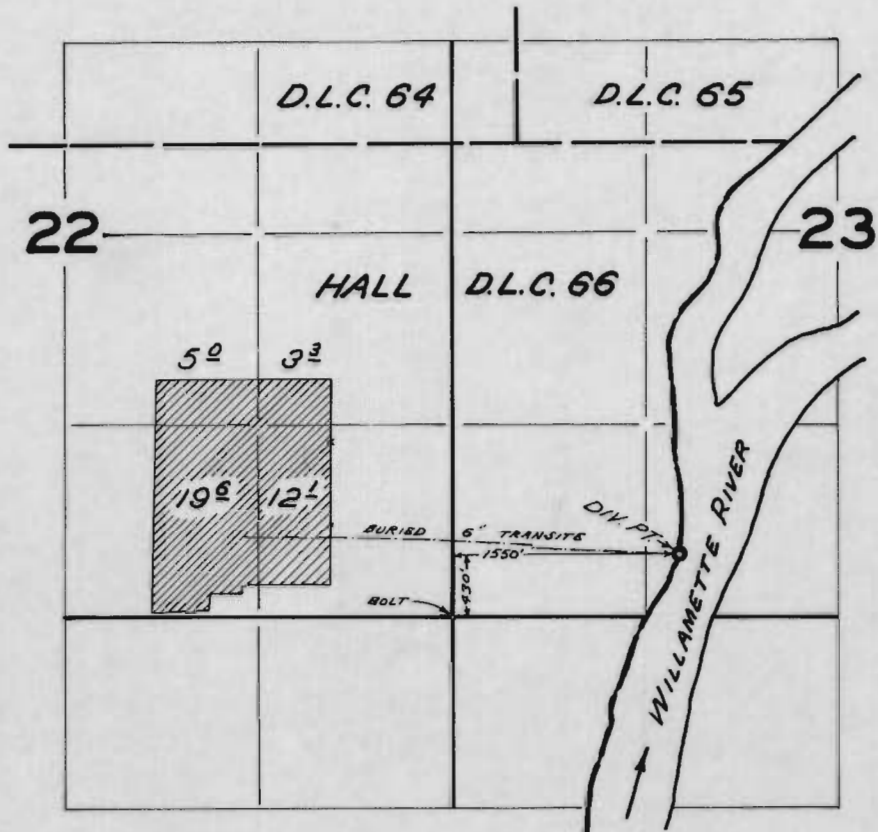

FINAL PROOF SURVEY
UNDER

Application No. 42121 Permit No. 31399
IN NAME OF

DANE J. PURVINE

Surveyed MAR 31 1967, by W.J. RUPPERT