


# T.4S. R.10W.W.M.

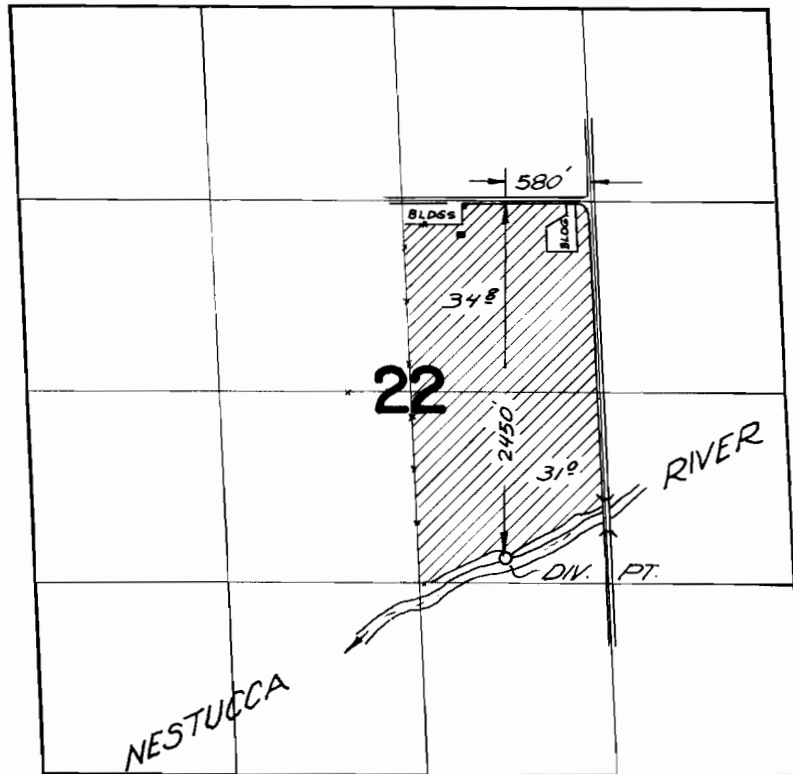

## FINAL PROOF SURVEY UNDER

Application No. 37852 Permit No. 28215  
IN NAME OF

WILFORD D. ROCK

Surveyed Sept 25 1967, by V. Garner