


T. 3S. R. 9W. W.M.

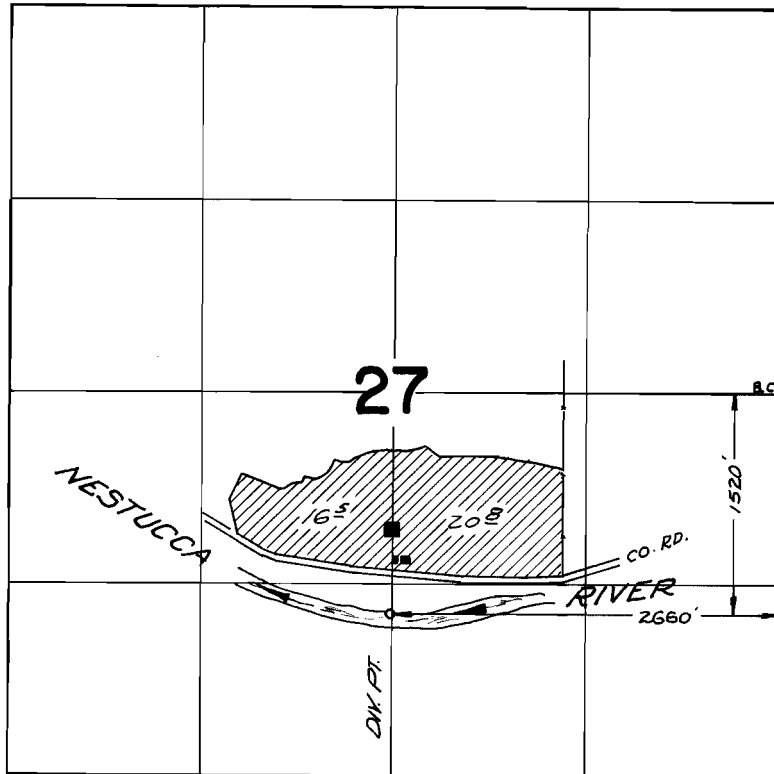

FINAL PROOF SURVEY
UNDER

Application No. 39896.. Permit No. 29696..
IN NAME OF

.....*E. R. MEASOR*.....

Surveyed *Sept. 28, 1967*, by *V. Garner*.....