


T.4S. R.10W. W.M.

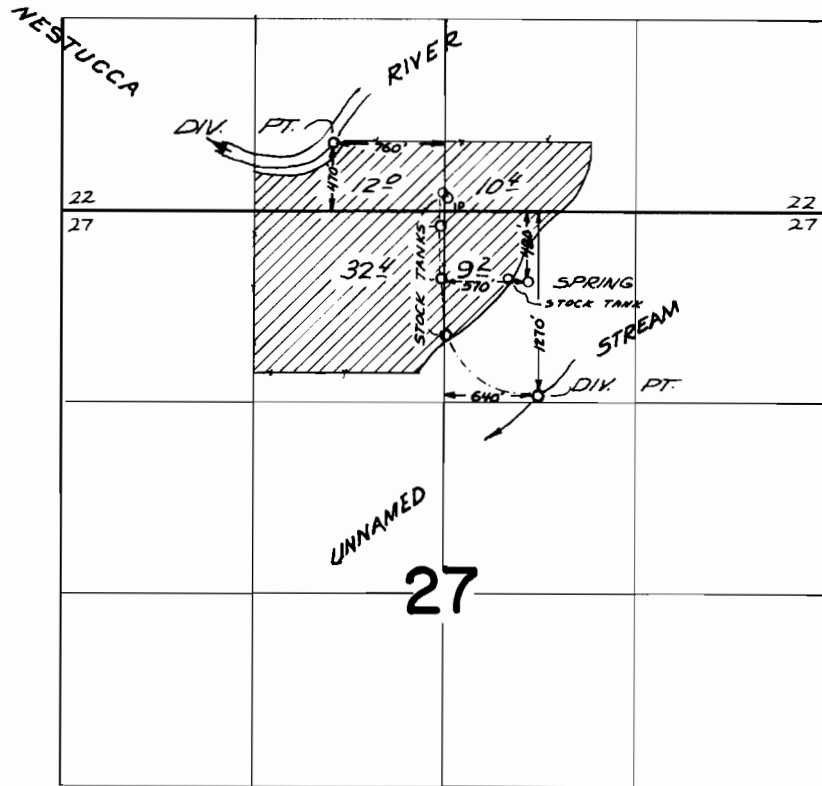

FINAL PROOF SURVEY UNDER

Application No. 42472 Permit No. 31765
IN NAME OF

HOWARD A. and BETTY J. OWENS

Surveyed Sept 26 1967, by *V. Garner*