
T.3N.R.29E.W.M.

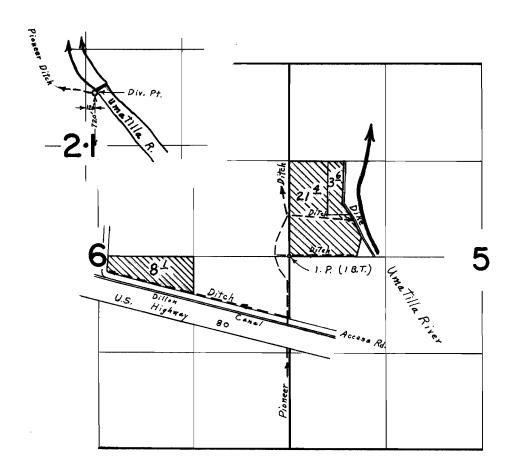

FINAL PROOF SURVEY

Application No. 38681... Permit No. 29198... IN NAME OF

ERNEST R. SIRES

Surveyed June 29, 1967, by L.E. Gould