


# T. 3 S. R. 38 E. W. M.

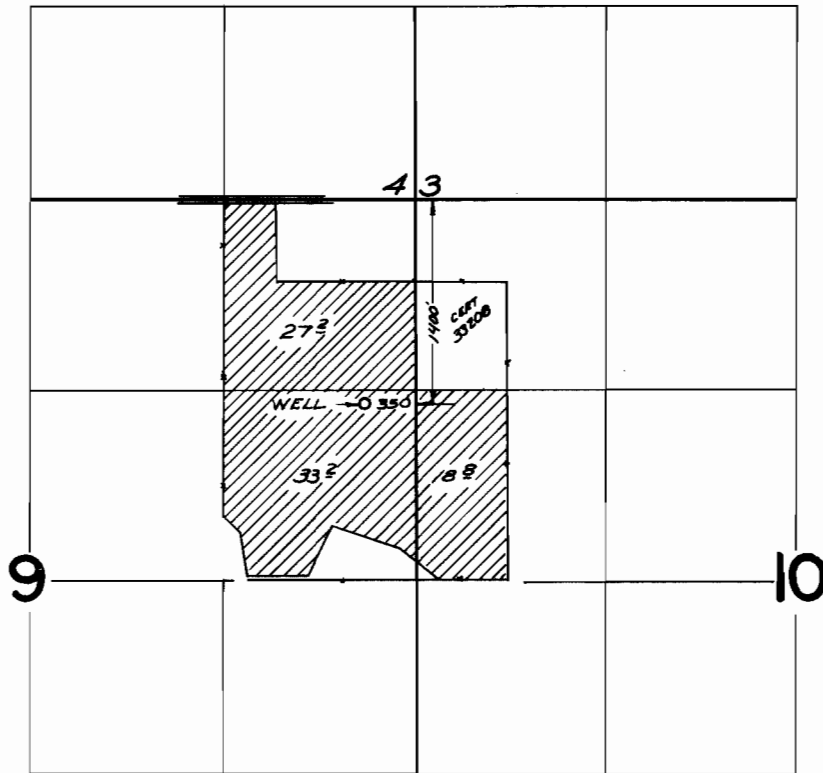

## FINAL PROOF SURVEY UNDER

Application No. *G:3412* Permit No. *G:3200*  
IN NAME OF  
*UNION STAKE CHURCH OF JESUS CHRIST*  
*OF LATTER DAY SAINTS*

Surveyed *Nov. 4* 1965, by *C. Gardner*  
*INSPECTED Aug 31, 1967* by *V. Garner*