


T.2 & 3 S. R.39 E. W.M.

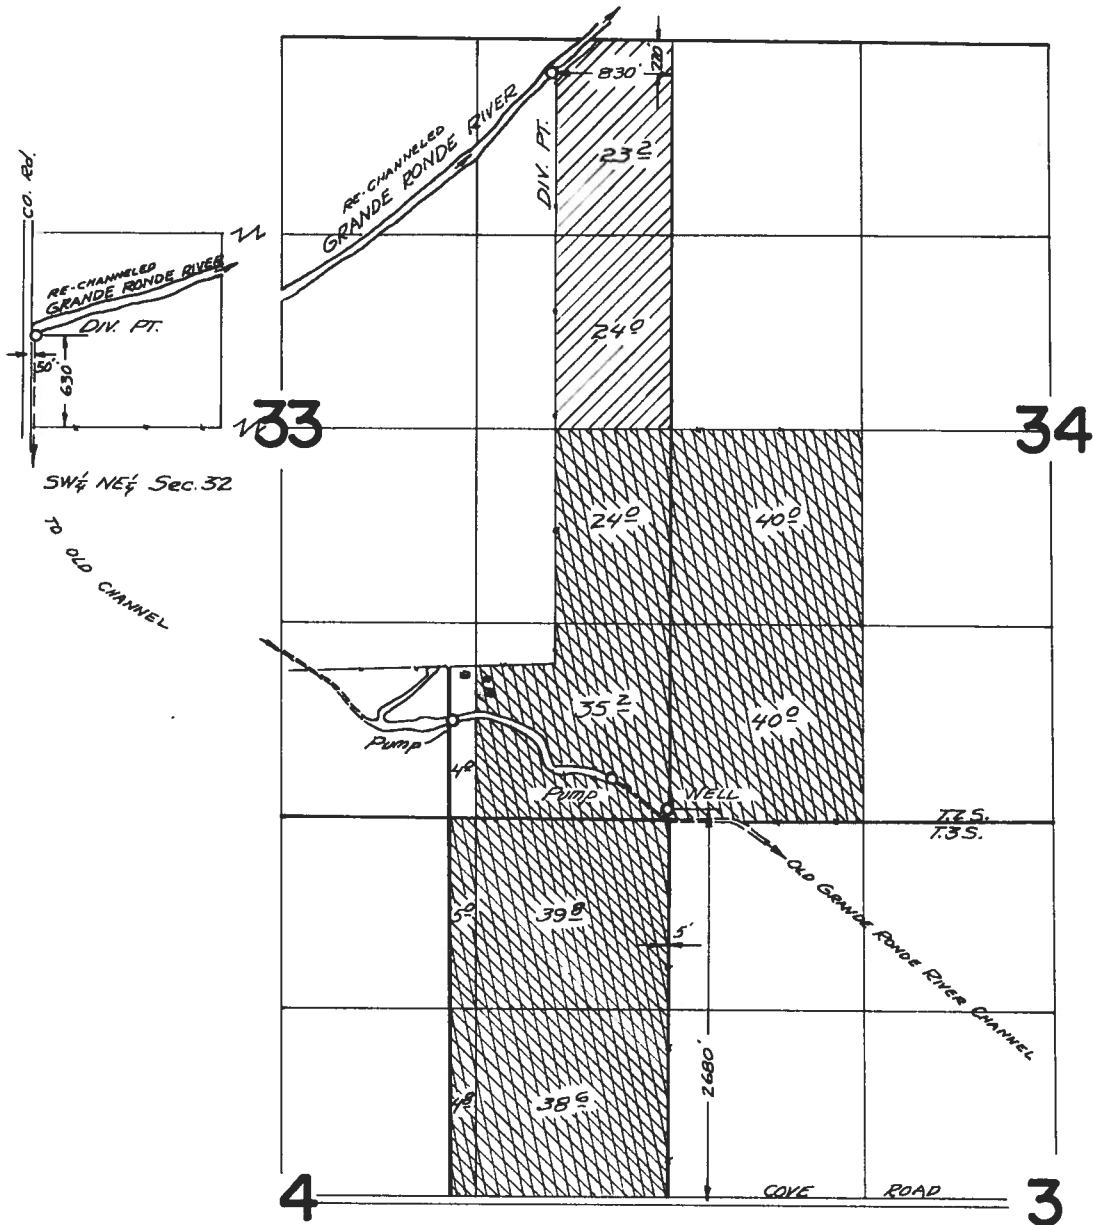

FINAL PROOF SURVEY UNDER

37397

27837

38408

28706

Application No. G-2790 Permit No. G-2600
IN NAME OF

ROBERT E. GULZOW

Surveyed AUG 24, 1967, by V. GARNER

