


T.I.S.R. 43E. W.M.

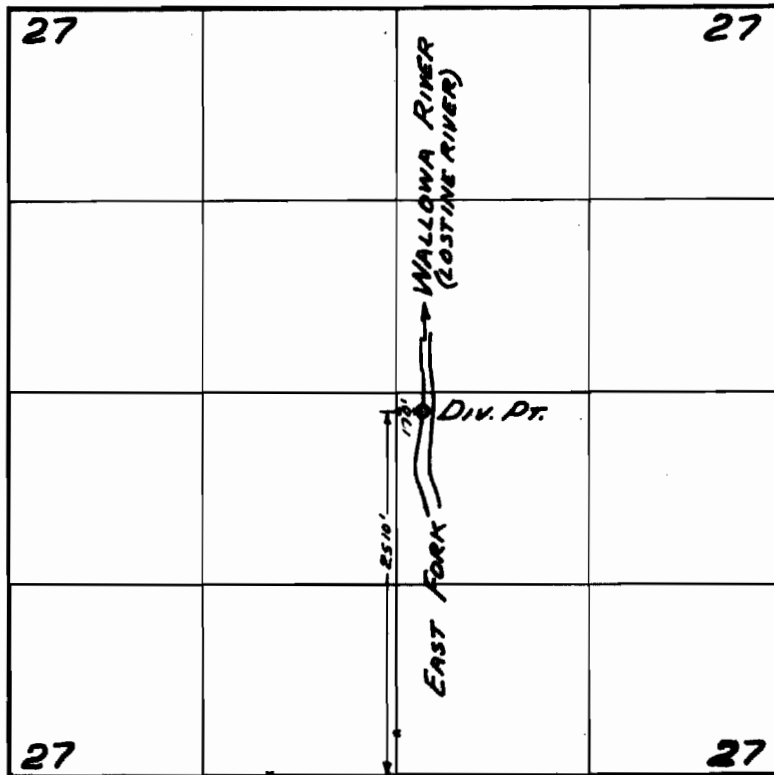

APPLICANT'S MAP ACCEPTED FOR LOCATIONS OF
PLACE OF USE AND SPRING

FINAL PROOF SURVEY UNDER

Application No. 41180 Permit No. 30966
IN NAME OF

E. M. AND RUTH MAKIN

Oct. 5 1967
Surveyed JUN 28 1966, by V. GARNER